

DRAWING INDEX	
ROOM	SHEET #
SPECIFICATIONS	A
1. TYPICAL RESIDENT HALLWAYS	1.0
2. RESTROOMS	2.0
3. LOBBY RECEPTION DECK	3.0
4. LIBRARY	4.0
5. MAILROOM	5.0
6. SOCIAL ROOM (EAST END)	6.0
7. SOCIAL ROOM (WEST END)	7.0
8. WAITING ROOM	8.0
SECTION VIEWS	D-1 - D-5
CUT SHEETS	CS-1 - CS-4

STAMPS & APPROVALS

Refer to submittal package 06-400-1

Feature Wall to follow

SHOP DRAWING / SUBMITTAL REVIEW

☒ APPROVED

☐ APPROVED WITH CHANGES NOTED

☐ REVISE AND RESUBMIT

☐ REJECTED:_____

SUBMITTAL WAS REVIEWED FOR DESIGN CONFORMITY AND GENERAL CONFORMANCE TO CONTRACT DOCUMENTS ONLY. THE CONTRACTOR IS RESPONSIBLE FOR CONFIRMING AND CORRELATING DIMENSIONS AT JOB SITES FOR TOLERANCES, CLEARANCES, QUANTITIES, FABRICATION PROCESSES AND TECHNIQUES OF CONSTRUCTION, COORDINATION OF HIS WORK WITH OTHER TRADES AND FULL COMPLIANCE WITH THE CONTRACT DOCUMENTS.

BY MCH DATE 7/13/26

 BLUE HORIZON
CONSTRUCTION

CASEWORK SPECIFICATIONS

ARCHITECTURAL WOODWORK SPECIFICATIONS:

I. STAINED WOOD CASEWORK:

- SIDES/BOTTOMS/TOPS: 3/4" PLYWOOD WITH PRE-FINISHED CLEAR MAPLE INTERIOR
- BACKS: 1/4" PLYWOOD W/ PRE-FINISHED CLEAR MAPLE ONE SIDE
- DOORS/DRAWER FRONTS: 3/4" MDF SLAB DOORS WITH WOOD VENEER STAINED TO MATCH APPROVED SAMPLE.
- EXTERIOR: WOOD VENEER STAINED TO MATCH APPROVED SAMPLE
- CABINET EDGEBANDING: WOOD VENEER STAINED TO MATCH APPROVED SAMPLE
- DOOR/DRAWER FRONT EDGEBANDING: N/A
- SHELVES: 3/4" PRE-FINISHED MAPLE PLYWOOD - LINE BORE ADJUSTABLE SHELVES
- TOEKICKS: 3/4" A/C ARAUCO PLYWOOD WITH STAINED WOOD VENEER OR SOLID WOOD BASE
- DRAWERS: 5/8" ASPEN WOOD WITH DOVETAIL CORNERS AND CLEAR UV FINISH
- SKIRTS/SUPPORTS: 3/4" A/C ARAUCO PLYWOOD
- COUNTERS: REFER TO ELEVATIONS
- HARDWARE: UNDER-MOUNT SOFT CLOSE DRAWER GUIDES, SOFT CLOSE CONCEALED HINGES, AND STEEL SHELF PINS. (REFER TO SPEC SHEETS)

II. FINISHES: REFER TO ELEVATIONS

GENERAL NOTES

1. ALL DIMENSIONS FIELD VERIFIED BY JOHN JEWELL, INC PRIOR TO PRODUCTION.

2. STANDARD FABRICATION TIME REQUIRED IS 4-6 WEEKS FROM FINAL FIELD MEASURE.

3. DRAWINGS CAN ONLY BE SCALED WITH 11"X17" PLOT.

HARDWARE SCHEDULE

ITEM	MANUFACTURER	PART #
1. CABINET PULLS	BYO	BYO
2. CONCEALED HINGE	BLUM	SOFT CLOSE
3. DRAWER GUIDE	BLUM	UNDER-MOUNT / SOFT CLOSE
4. SHELF SUPPORTS	KNAPE & VOGT	332ANO



JOHN JEWELL

CRAFTER OF FINE CABINETRY & MILLWORK

25550 TECHNOLOGY BLVD
PUNTA GORDA, FL 33950

PROJECT CONTACT
NAME: DOUG SLOAN
PHONE: (941) 815-6235

PROJECT:

THE VISTAS AT GULF SHORE BLVD
4651 GULF SHORE BLVD.
NAPLES, FL 34103

CLIENT:



BLUE HORIZON
CONSTRUCTION

CONTACT: GREG SHAVALIER


ORIGINAL DRAWING DATE

7/10/26


DRAWING REVISIONS

△	
△	
A

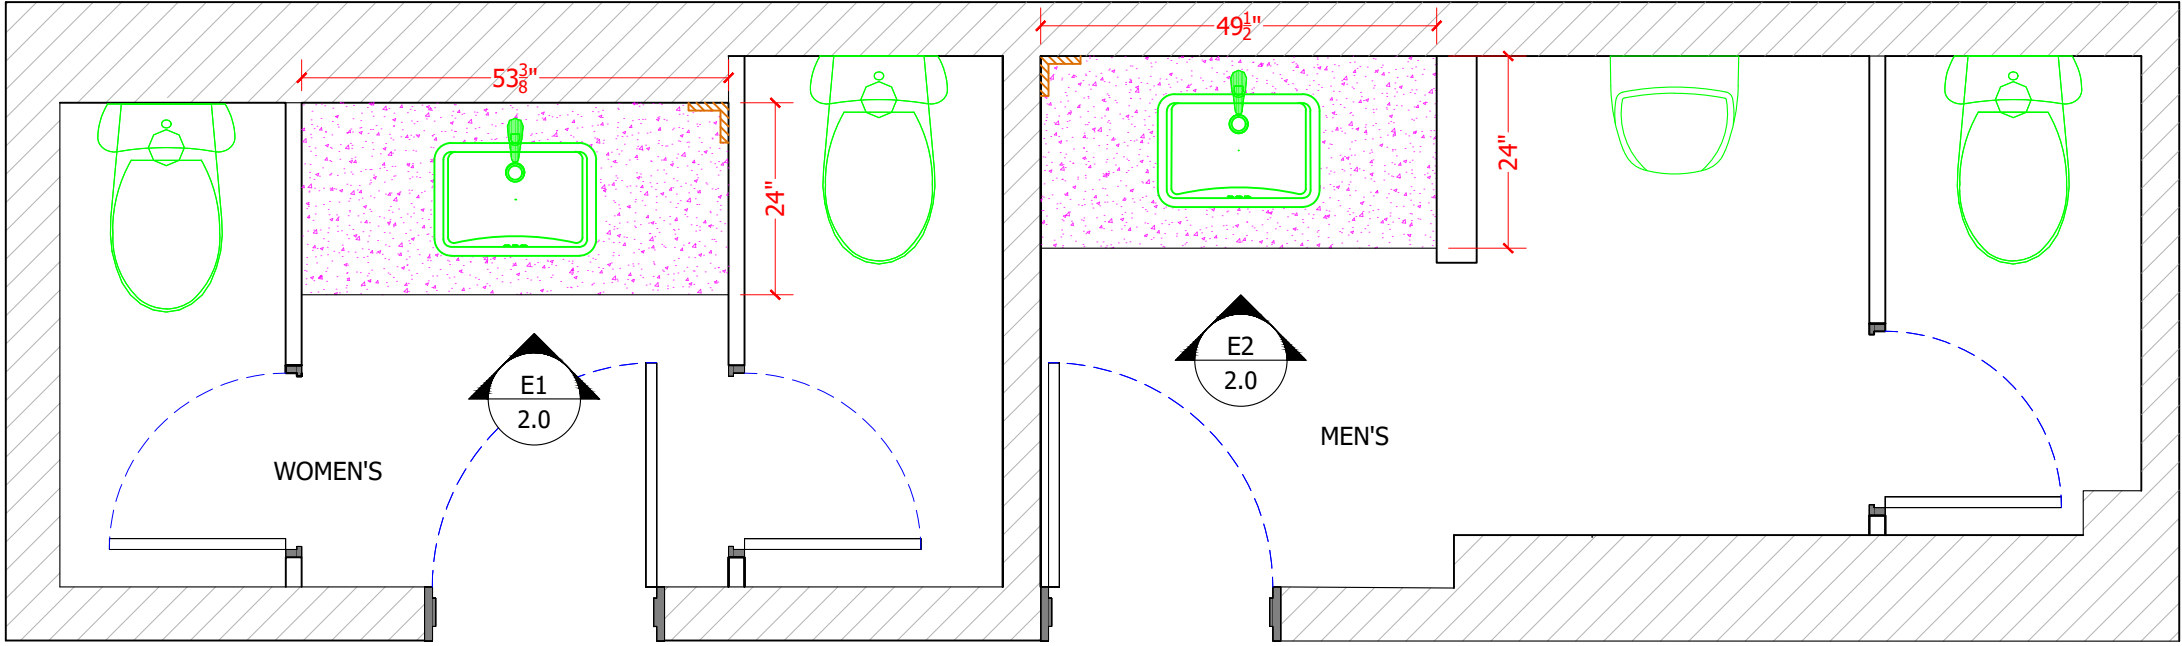

2 RESTROOMS
Scale: 1/2"=1'-0"

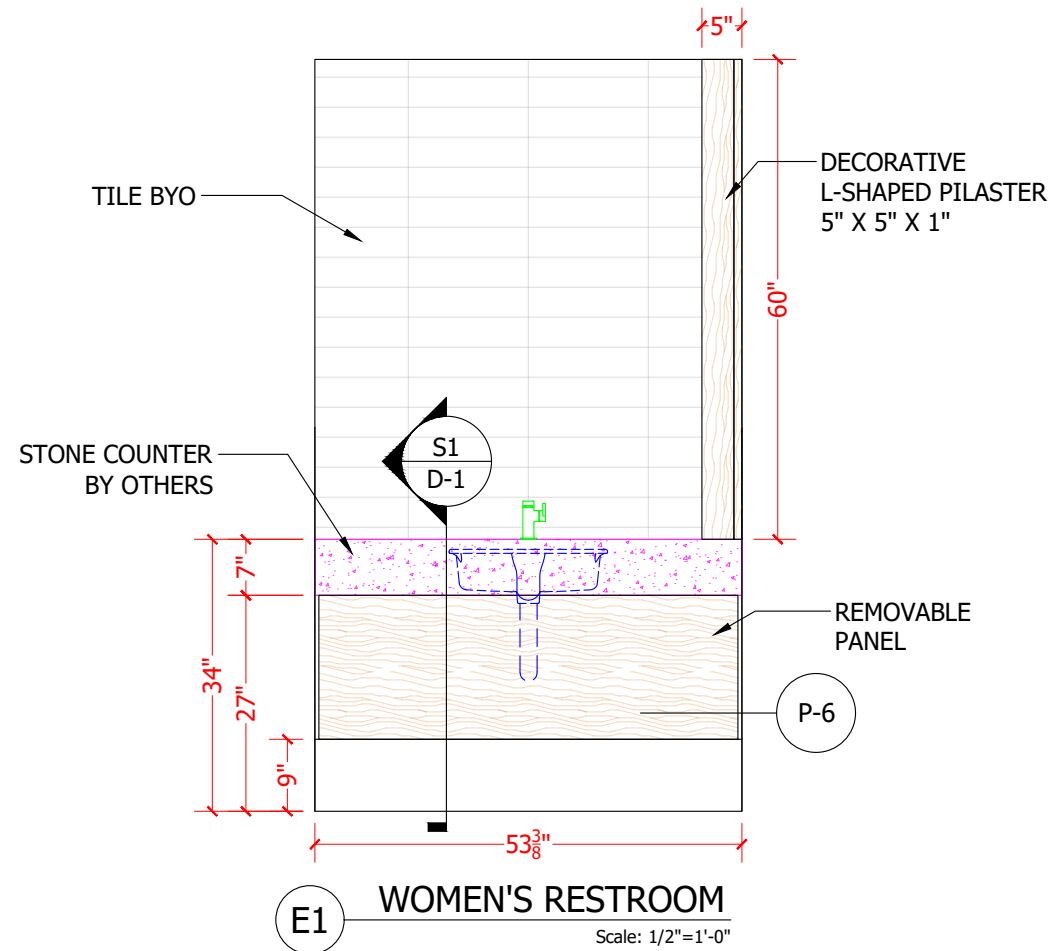

CASEWORK FINISHES:
(P-6) MAPLE VENEER STAINED TO MATCH "PHANTOM COCOA"
COUNTERS: STONE BY OTHERS

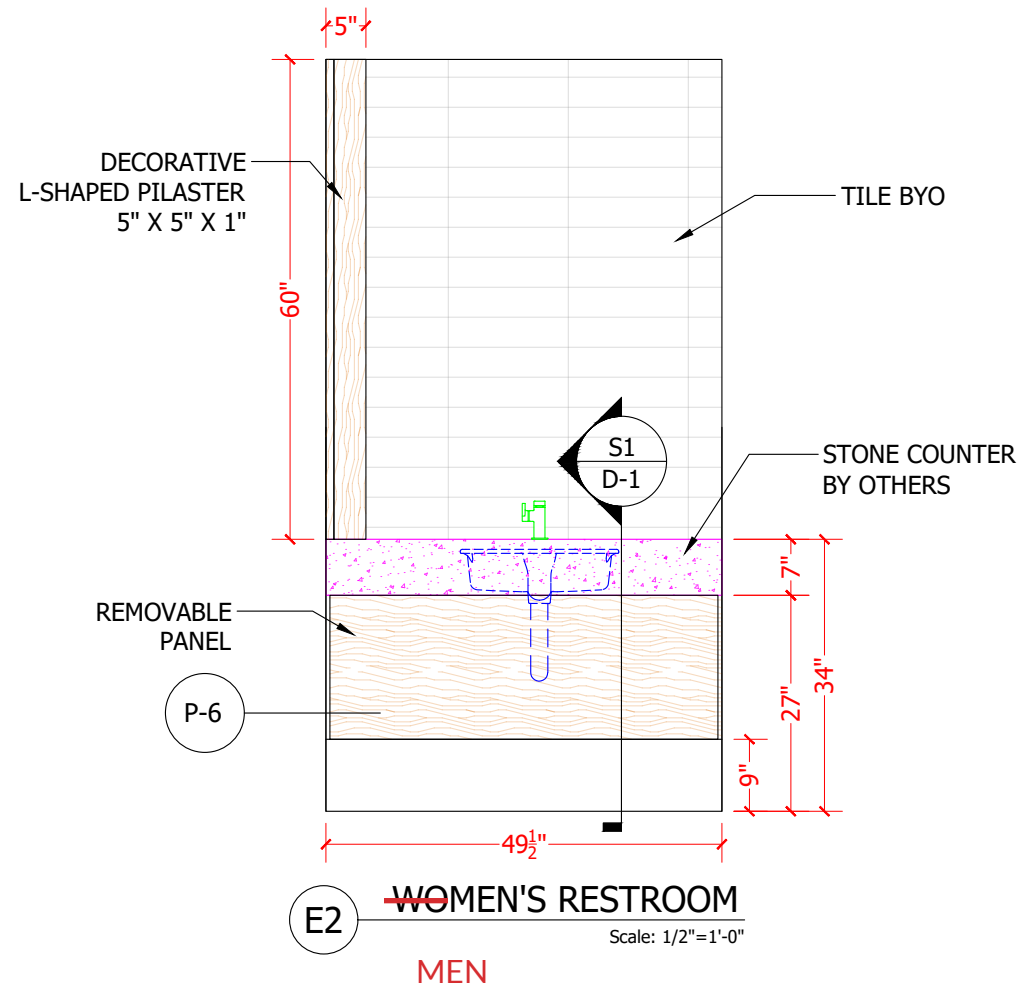


25550 TECHNOLOGY BLVD
PUNTA GORDA, FL 33950
PROJECT CONTACT
NAME: DOUG SLOAN
PHONE: (941) 815-6235

PROJECT:
THE VISTAS AT GULF SHORE BLVD
4651 GULF SHORE BLVD.
NAPLES, FL 34103

CLIENT:
BLUE HORIZON
CONSTRUCTION
CONTACT: GREG SHAVALIER

ORIGINAL DRAWING DATE	
7/10/26	
DRAWING REVISIONS	
△	
△	
CLIENT-COMPUTER-EQUIPMENT
VENDOR TO CONFIRM. TV
MONITOR ARE 15"X15. MAYBE
CONSIDER TO TAKE THE UPPER
PART AT 44" AND WORK DESK AT
29" FOR NOW-TBD

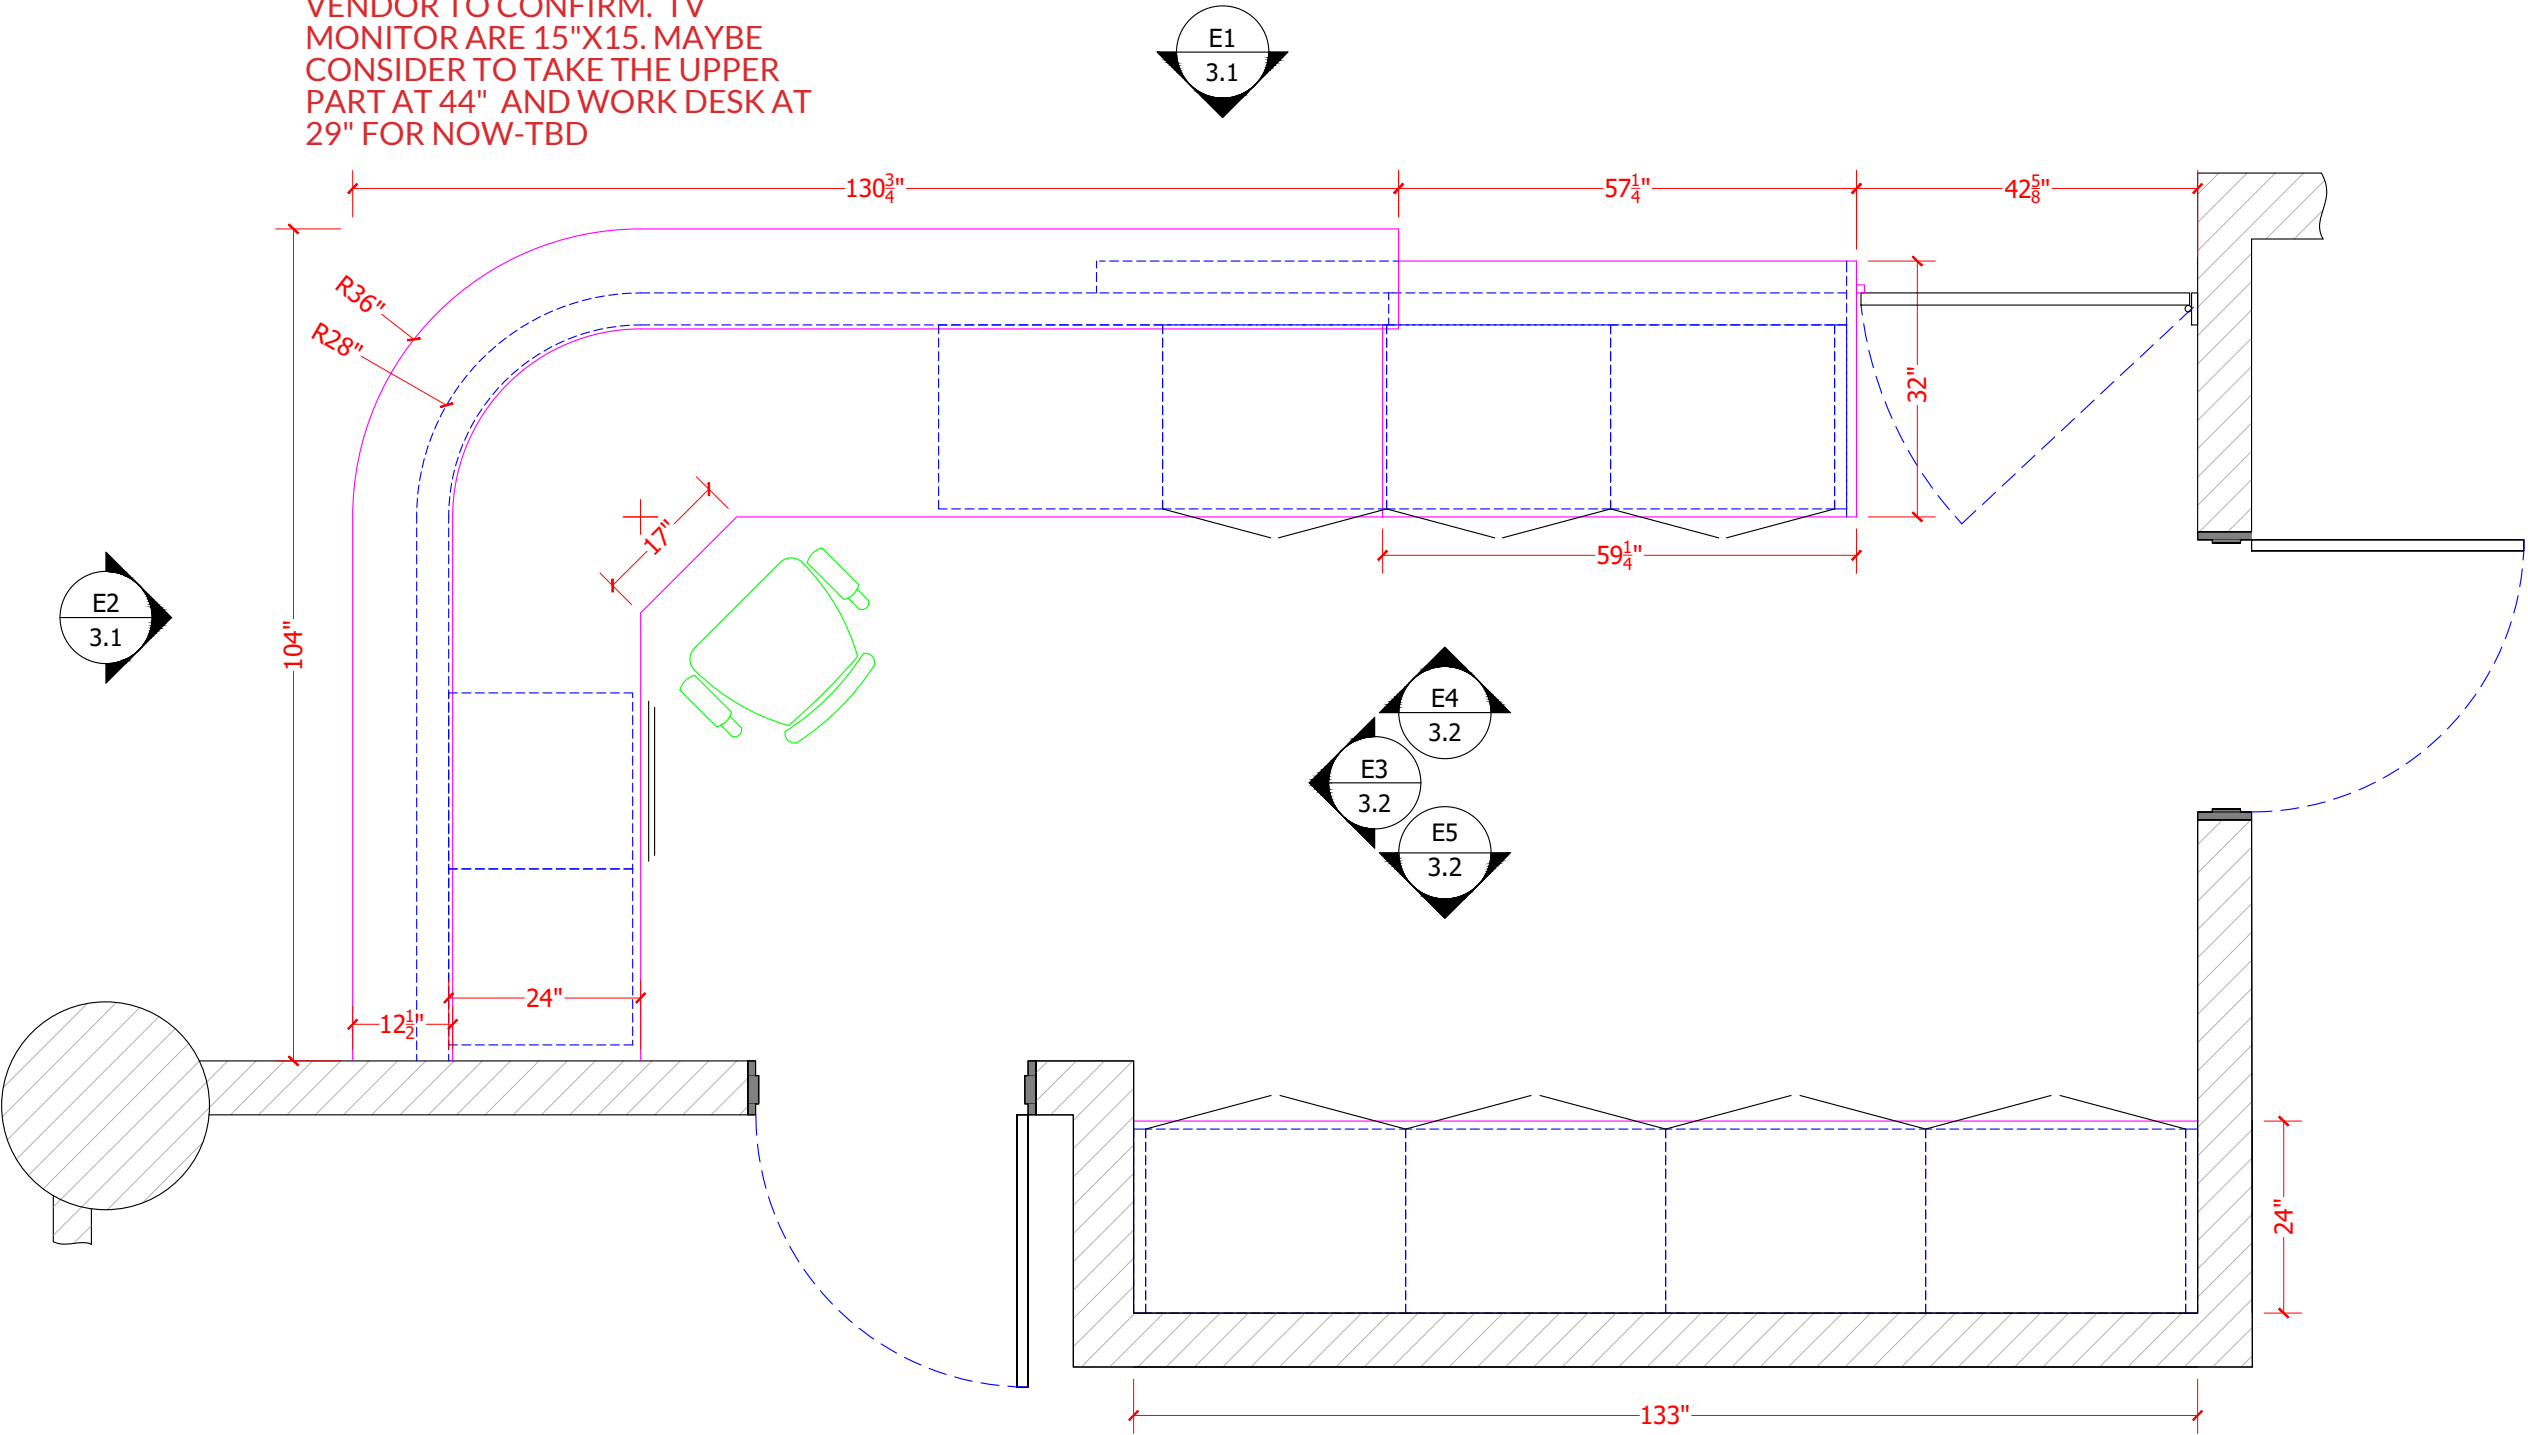

3 LOBBY RECEPTION DESK
Scale: 1/2"=1'-0"

CASEWORK FINISHES:
(P-5) MAPLE VENEER STAINED TO MATCH "CHARRED CLAY"
(P-6) MAPLE VENEER STAINED TO MATCH "PHANTOM COCOA"
(P-7) OAK VENEER STAINED TO MATCH "BEIGEWOOD"
COUNTERS: STONE BY OTHERS

25550 TECHNOLOGY BLVD
PUNTA GORDA, FL 33950

PROJECT CONTACT
NAME: DOUG SLOAN
PHONE: (941) 815-6235

PROJECT:
THE VISTAS AT GULF SHORE BLVD
4651 GULF SHORE BLVD.
NAPLES, FL 34103

CLIENT:




CONTACT: GREG SHAVALIER

ORIGINAL DRAWING DATE	
7/10/26	
DRAWING REVISIONS	
△	
△	
PROJECT:
THE VISTAS AT GULF SHORE BLVD
4651 GULF SHORE BLVD.
NAPLES, FL 34103


CLIENT:
BLUE HORIZON
CONSTRUCTION
CONTACT: GREG SHAVALIER

ORIGINAL DRAWING DATE	
7/10/26	
DRAWING REVISIONS	
△	
△	
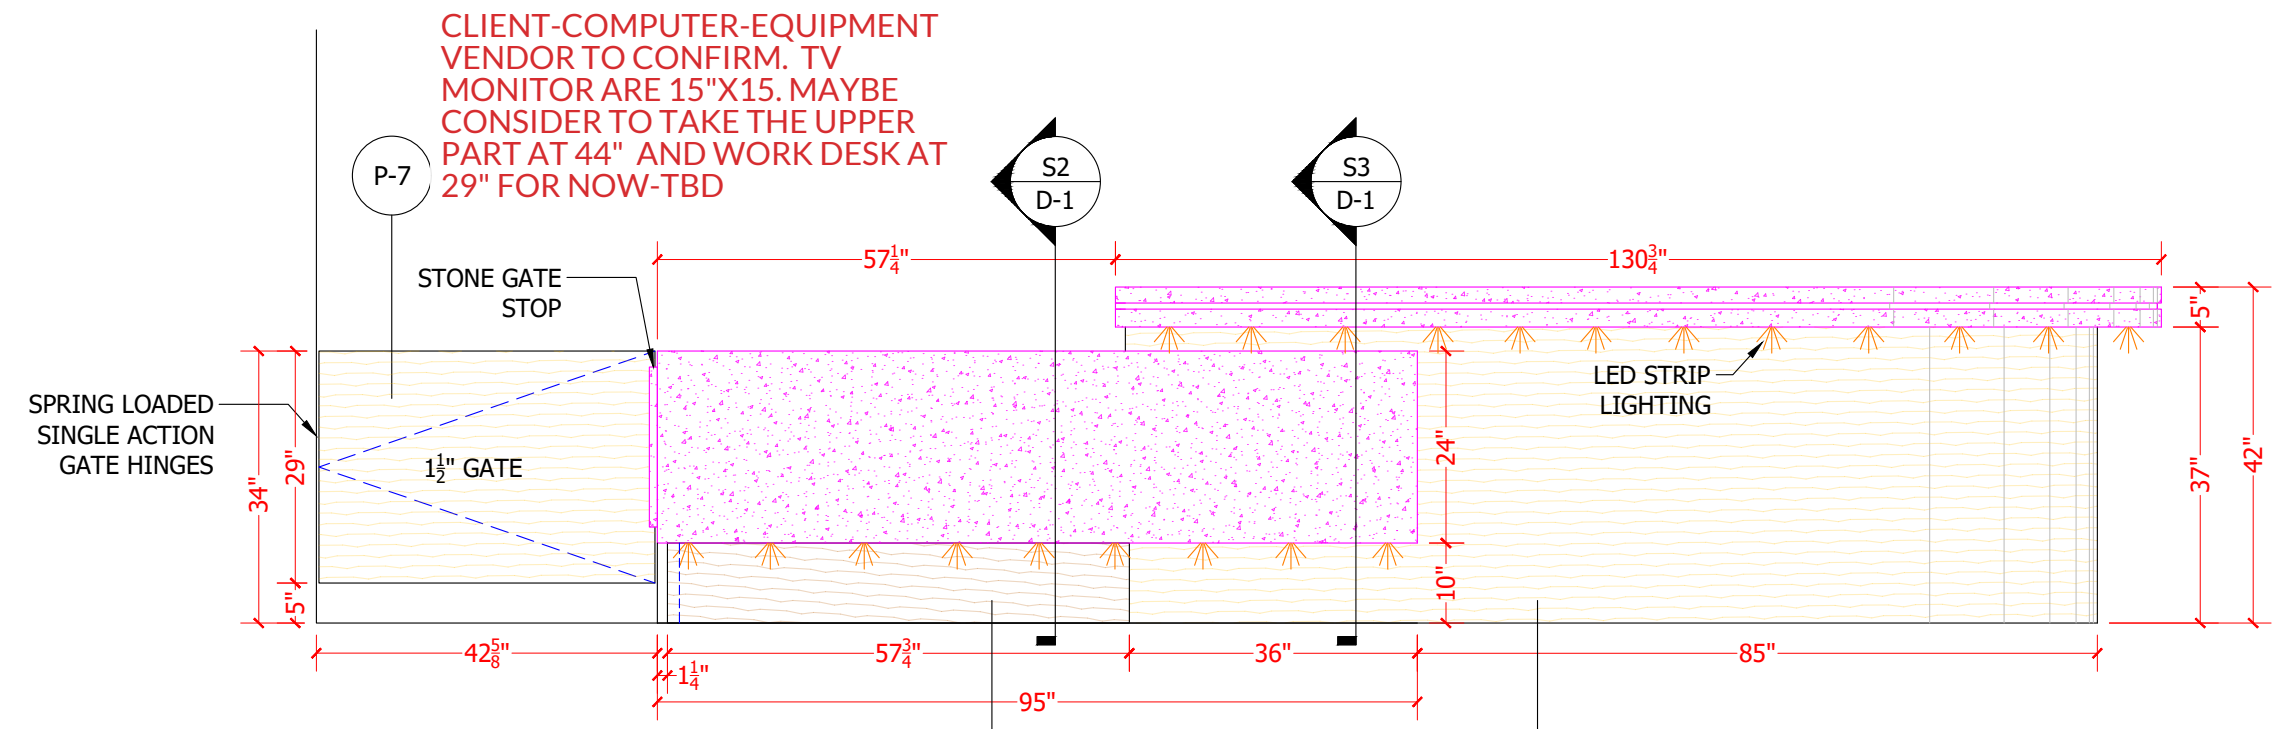


E1 LOBBY RECEPTION DESK
Scale: 1/2"=1'-0"

HATCH INDICATES
VENEER GRAIN
DIRECTION

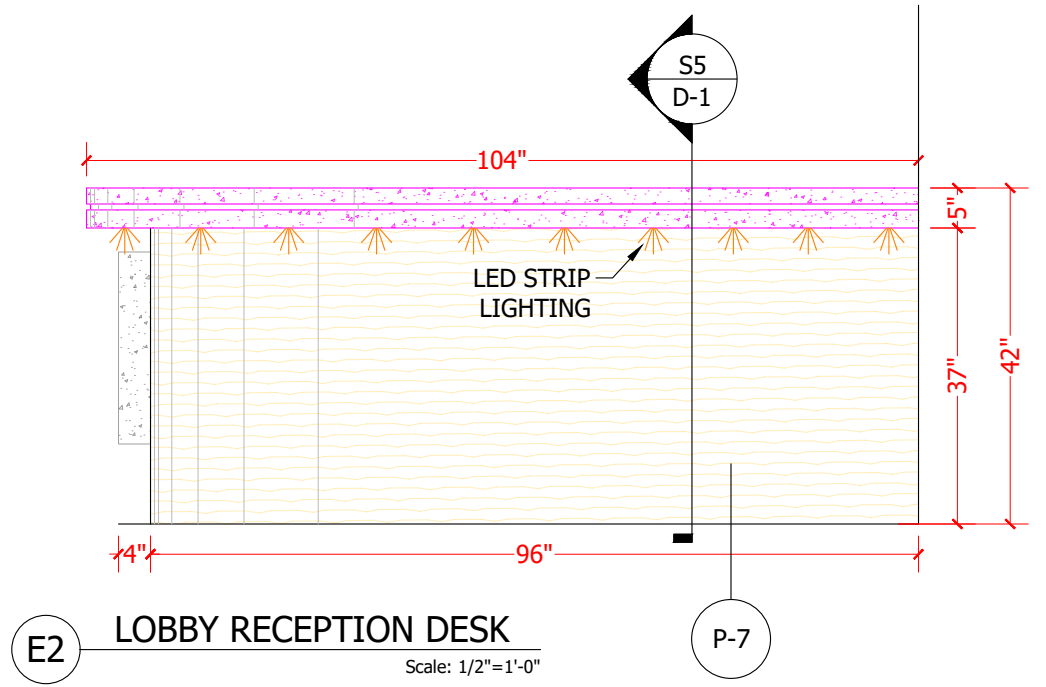


E2 LOBBY RECEPTION DESK
Scale: 1/2"=1'-0"

CASEWORK FINISHES:
(P-5) MAPLE VENEER STAINED TO MATCH "CHARRED CLAY"
(P-6) MAPLE VENEER STAINED TO MATCH "PHANTOM COCOA"
(P-7) OAK VENEER STAINED TO MATCH "BEIGEWOOD"
COUNTERS: STONE BY OTHERS
DECORATIVE HARDWARE: PROVIDED BY OTHERS & INSTALLED BY JJINC.

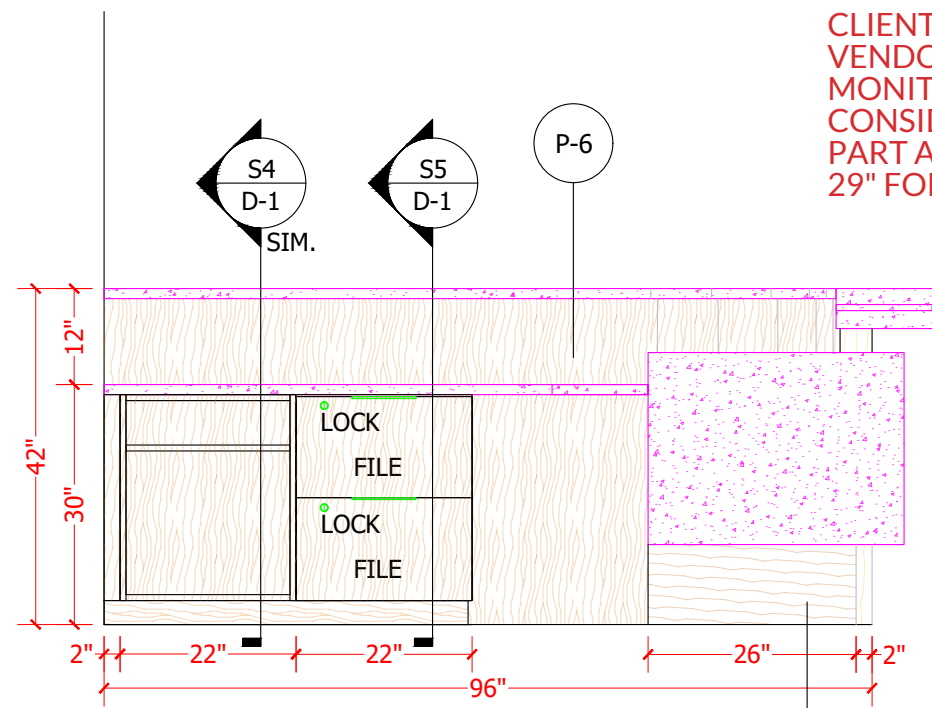


E3 LOBBY RECEPTION DESK
Scale: 1/2"=1'-0"

CLIENT-COMPUTER-EQUIPMENT
VENDOR TO CONFIRM. TV
MONITOR ARE 15"X15. MAYBE
CONSIDER TO TAKE THE UPPER
PART AT 44" AND WORK DESK AT
29" FOR NOW-TBD

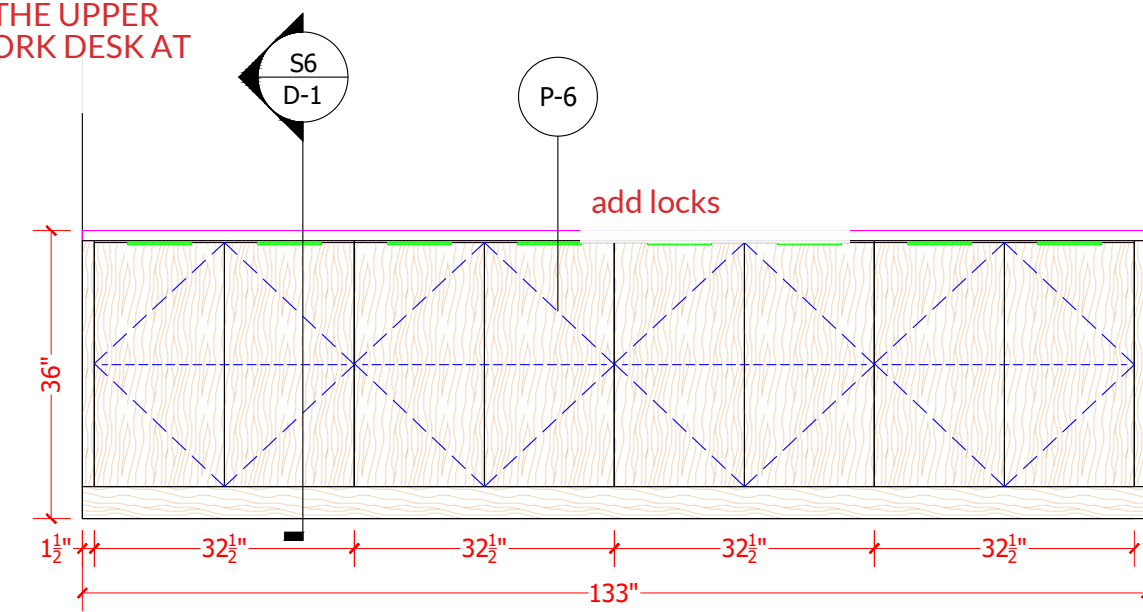

E5 LOBBY RECEPTION DESK
Scale: 1/2"=1'-0"

need to measure existing equipment,
specially the monitor

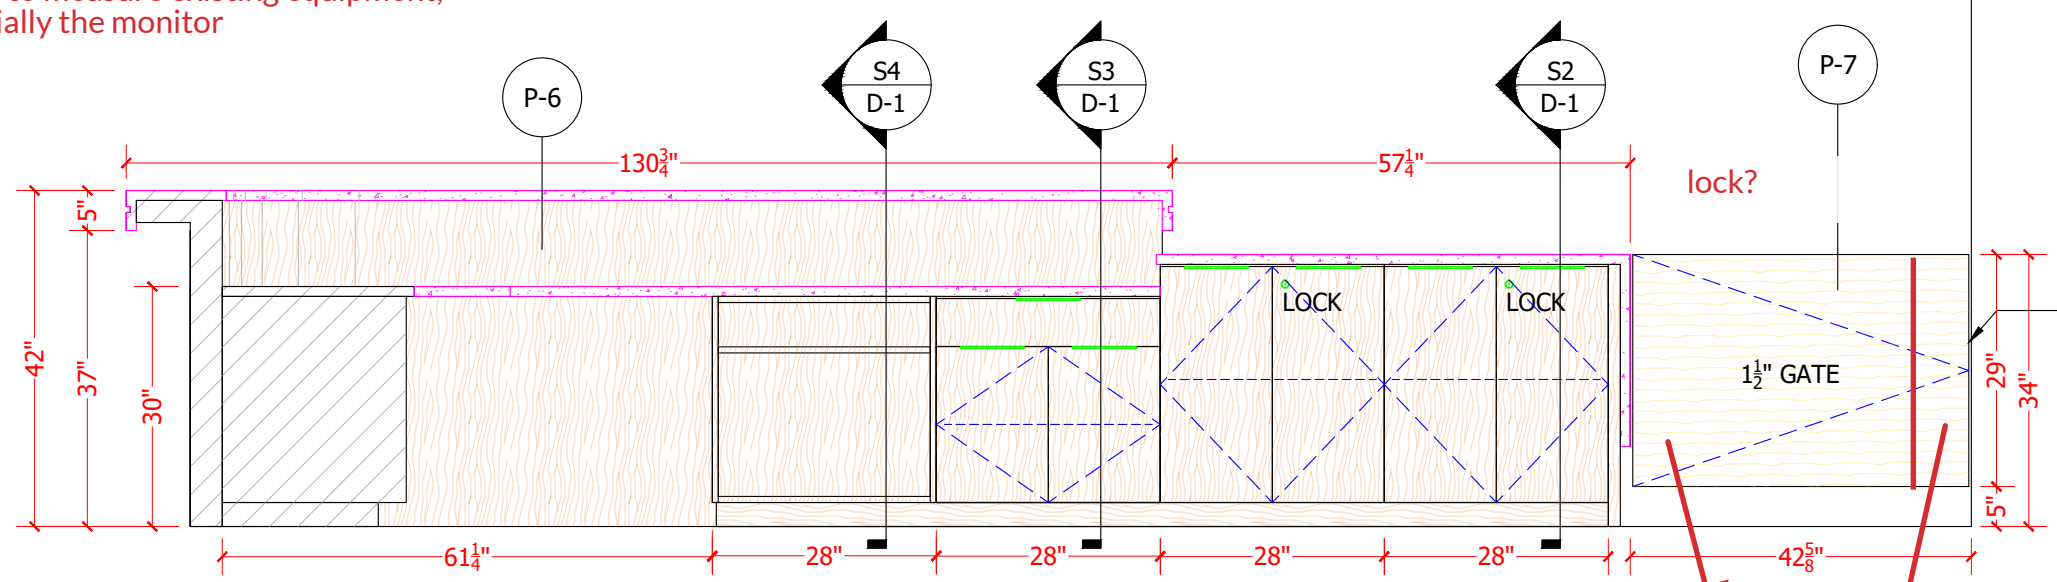

E4 LOBBY RECEPTION DESK
Scale: 1/2"=1'-0"

lock?

SPRING LOADED
SINGLE ACTION
GATE HINGES

36" door with 6.5" fixed
panel

HATCH INDICATES
VENEER GRAIN
DIRECTION

CASEWORK FINISHES:
(P-5) MAPLE VENEER STAINED TO MATCH "CHARRED CLAY"
(P-6) MAPLE VENEER STAINED TO MATCH "PHANTOM COCOA"
(P-7) OAK VENEER STAINED TO MATCH "BEIGEWOOD"
COUNTERS: STONE BY OTHERS
DECORATIVE HARDWARE: PROVIDED BY OTHERS & INSTALLED BY JJINC.



JOHN JEWELL
CRAFTER OF FINE CABINETS & MILLWORK

25550 TECHNOLOGY BLVD
PUNTA GORDA, FL 33950

PROJECT CONTACT
NAME: DOUG SLOAN
PHONE: (941) 815-6235

PROJECT:
THE VISTAS AT GULF SHORE BLVD
4651 GULF SHORE BLVD.
NAPLES, FL 34103

CLIENT:




CONTACT: GREG SHAVALIER

ORIGINAL DRAWING DATE
7/10/26

DRAWING REVISIONS

△	
△	
3.2

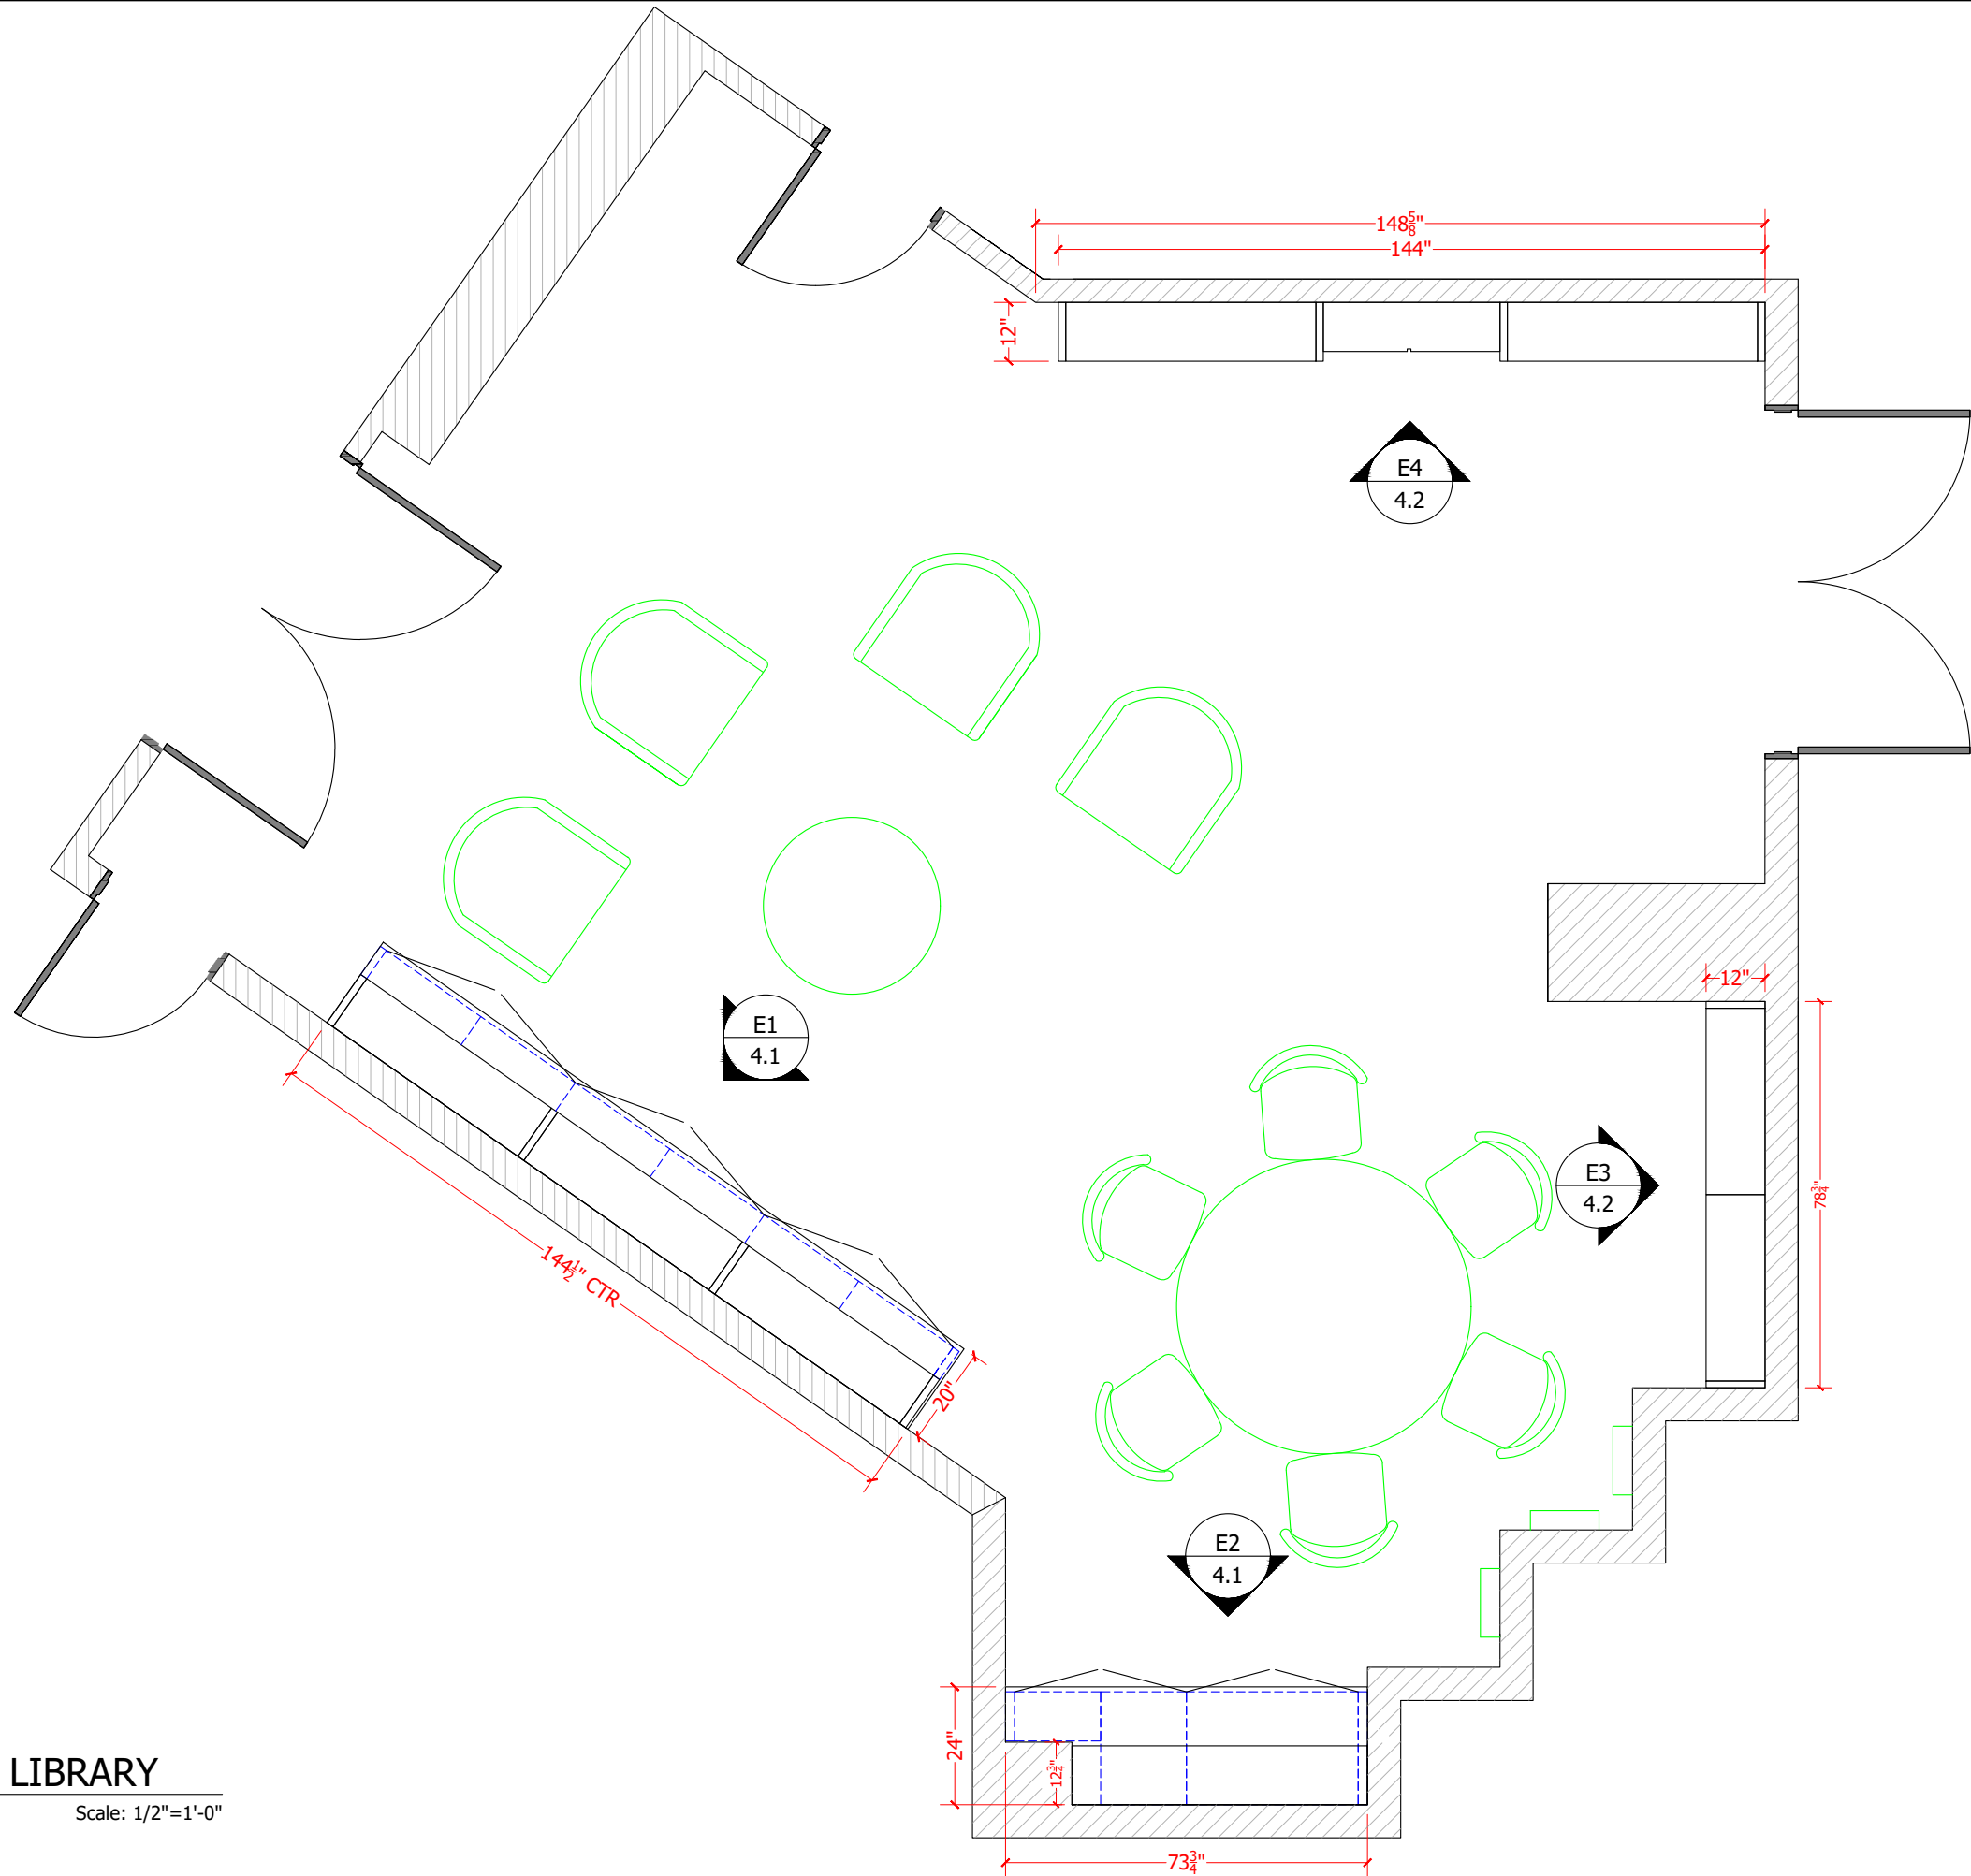

JOHN JEWELL

CRAFTER OF FINE CABINETS & MILLWORK

25550 TECHNOLOGY BLVD
PUNTA GORDA, FL 33950

PROJECT CONTACT
NAME: DOUG SLOAN
PHONE: (941) 815-6235

PROJECT:
THE VISTAS AT GULF SHORE BLVD
4651 GULF SHORE BLVD.
NAPLES, FL 34103

CLIENT:



CONTACT: GREG SHAVALIER

ORIGINAL DRAWING DATE

7/10/26

DRAWING REVISIONS

△	
△	
4.0

PROJECT:

THE VISTAS AT GULF SHORE BLVD
4651 GULF SHORE BLVD.
NAPLES, FL 34103


CLIENT:

BH

BLUE HORIZON
CONSTRUCTION

CONTACT: GREG SHAVALIER

ORIGINAL DRAWING DATE	
7/10/26	
DRAWING REVISIONS	
△	
△	
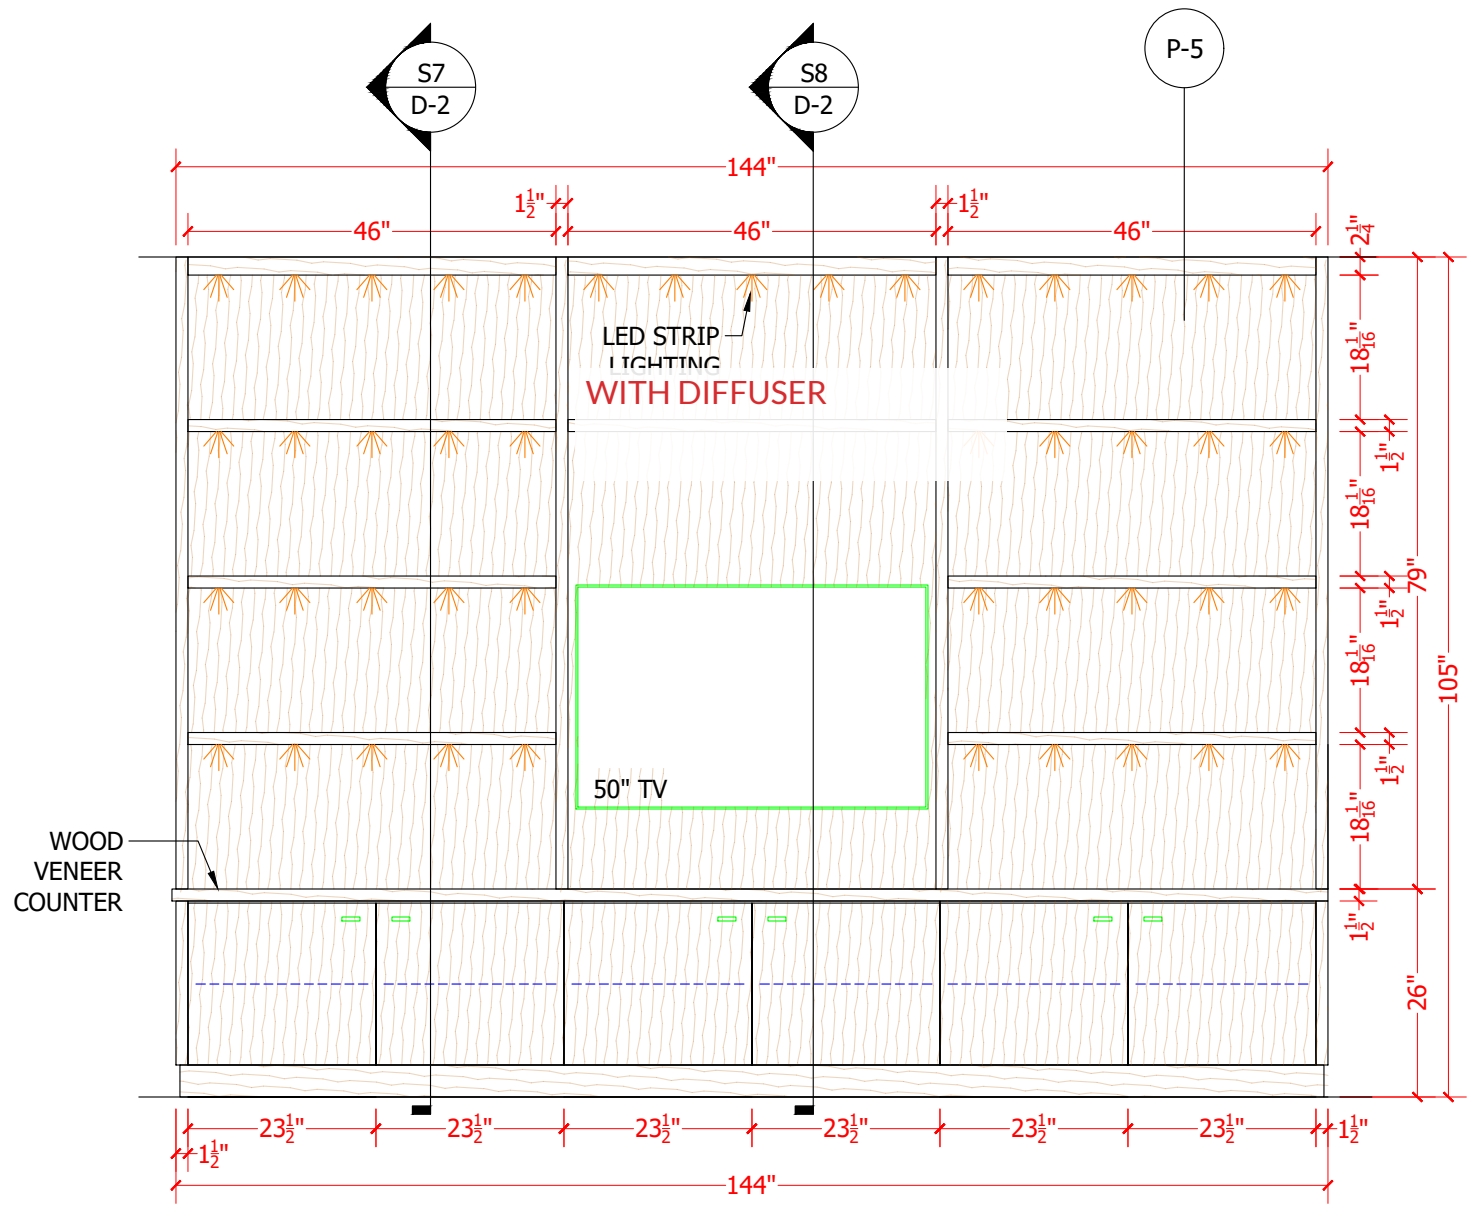

E1

LIBRARY


Scale: 1/2"=1'-0"

CASEWORK FINISHES:

(P-5) MAPLE VENEER STAINED TO MATCH "CHARRED CLAY" FINISH TO BE P6 FOR ALL

COUNTERS: STONE BY OTHERS

DECORATIVE HARDWARE: PROVIDED BY OTHERS & INSTALLED BY JJINC.

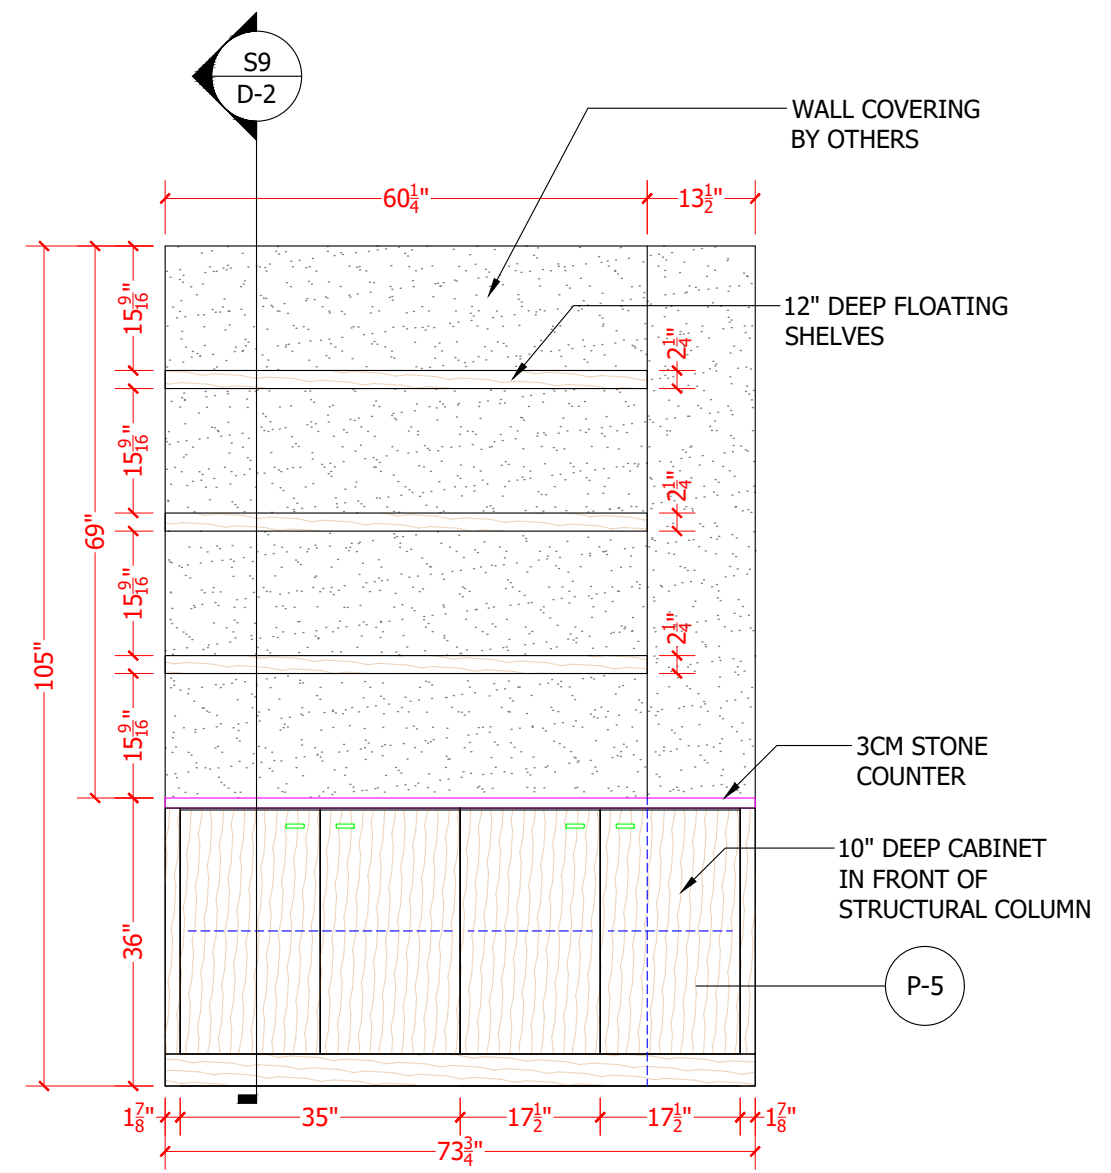

E2

LIBRARY



Scale: 1/2"=1'-0"

HATCH INDICATES
VENEER GRAIN
DIRECTION

PROJECT:
THE VISTAS AT GULF SHORE BLVD
4651 GULF SHORE BLVD.
NAPLES, FL 34103


CLIENT:
 **BLUE HORIZON**
CONSTRUCTION
CONTACT: GREG SHAVALIER

ORIGINAL DRAWING DATE	
7/10/26	
DRAWING REVISIONS	
△	
△	
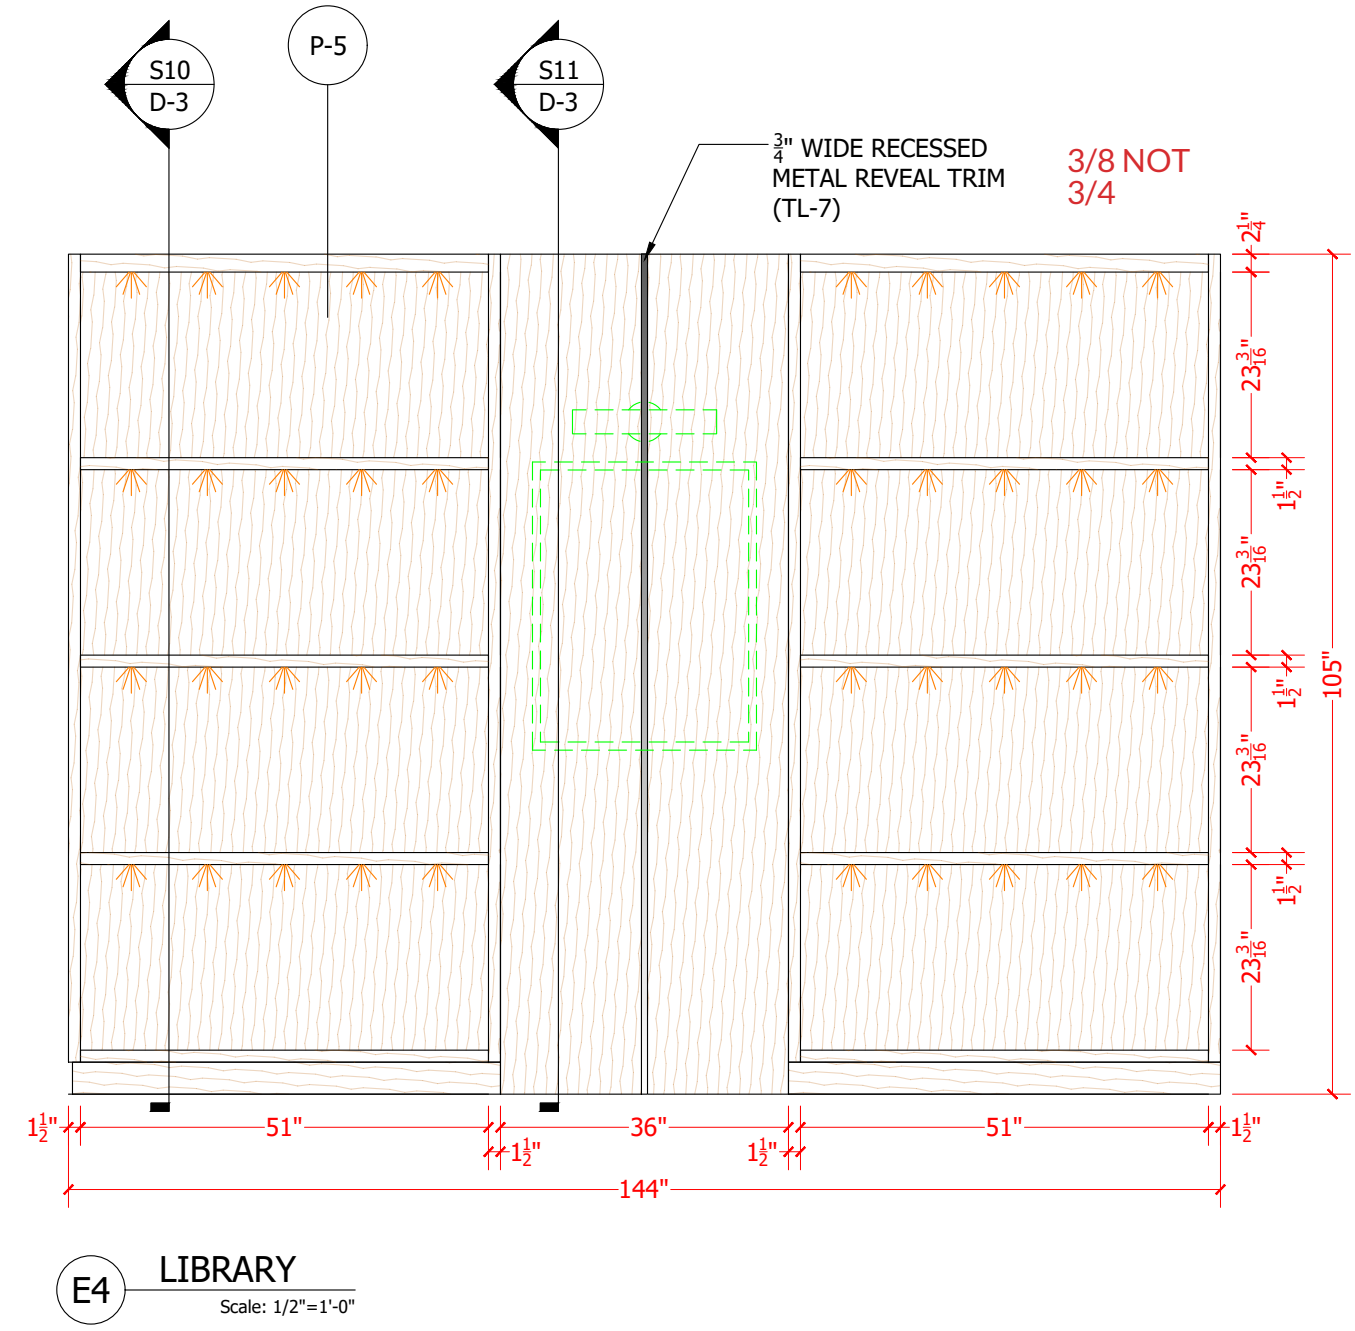
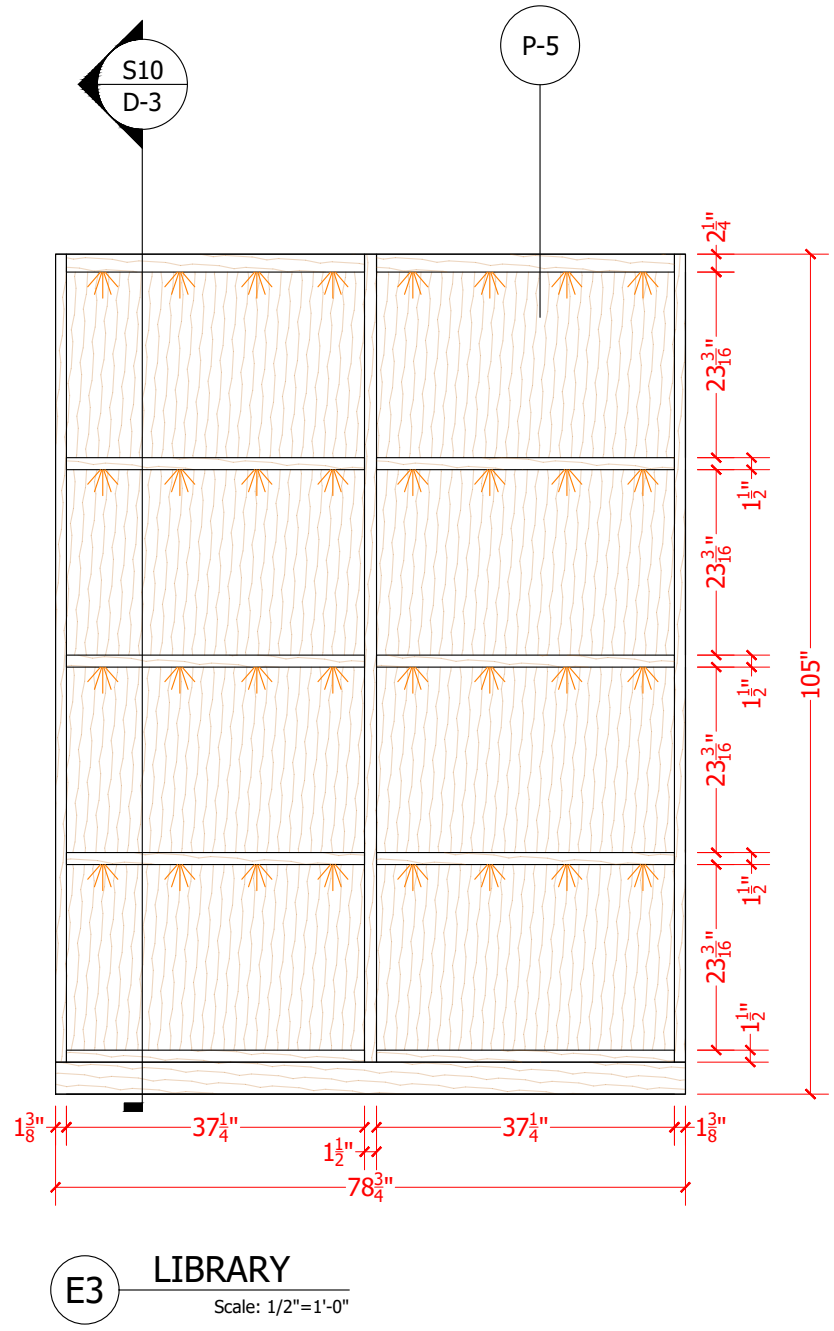


HATCH INDICATES
VENEER GRAIN
DIRECTION

CASEWORK FINISHES:
(P-5) MAPLE VENEER STAINED TO MATCH "CHARRED CLAY" **FINISH TO BE P6 FOR ALL**
COUNTERS: STONE BY OTHERS
DECORATIVE HARDWARE: PROVIDED BY OTHERS & INSTALLED BY JJINC.

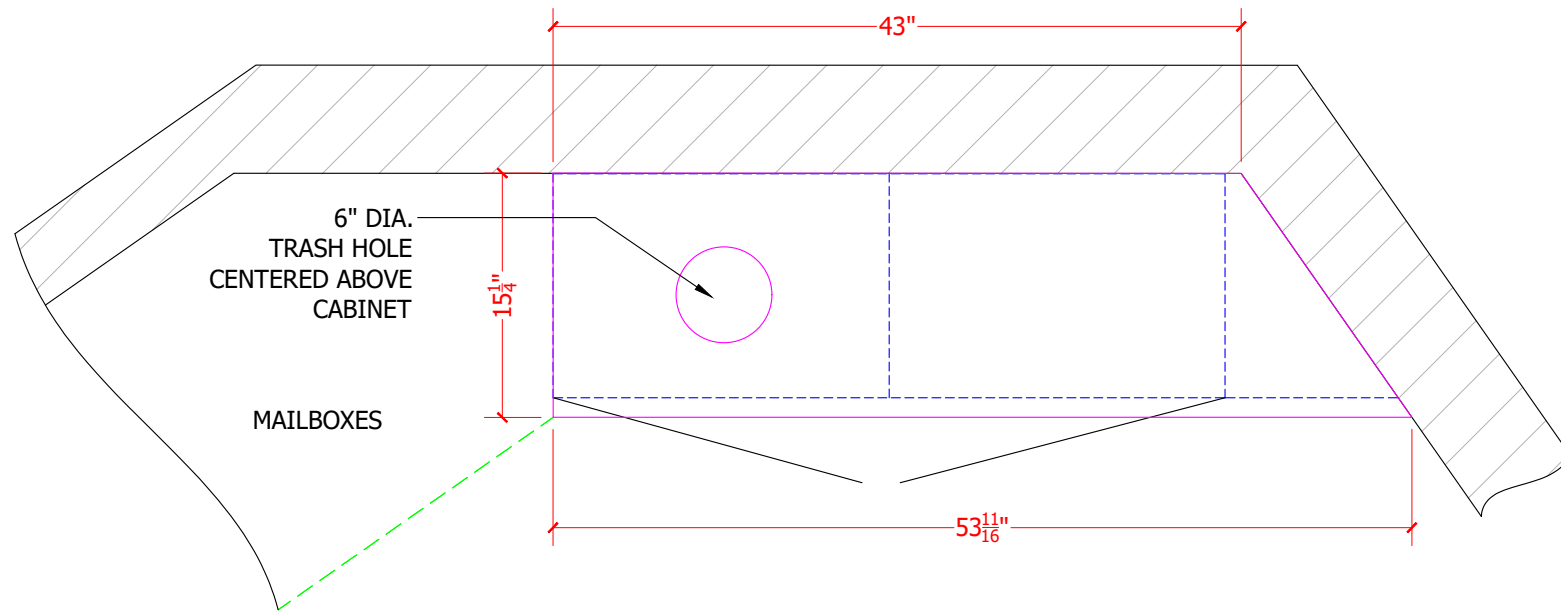

5 MAILROOM
Scale: 1"=1'-0"

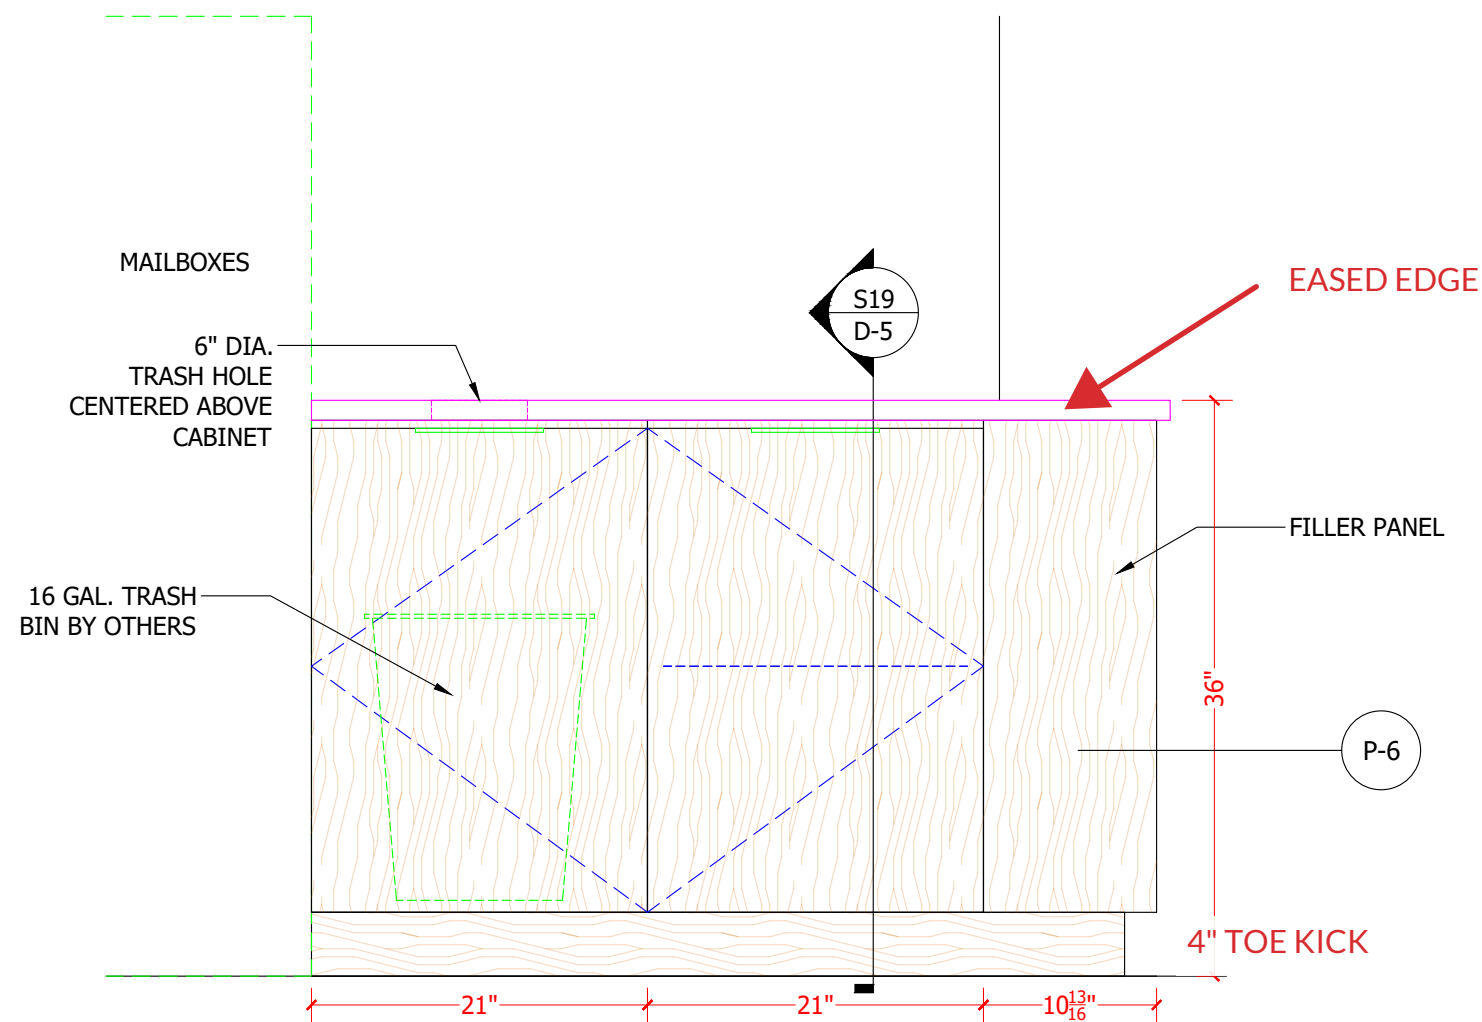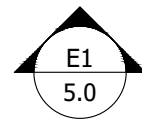

E1 MAILROOM
Scale: 1"=1'-0"

CASEWORK FINISHES:
(P-6) MAPLE VENEER STAINED TO MATCH "PHANTOM COCOA"
DECORATIVE HARDWARE: PROVIDED BY OTHERS & INSTALLED BY JJINC.



JOHN JEWELL

CRAFTER OF FINE CABINETS & MILLWORK

25550 TECHNOLOGY BLVD
PUNTA GORDA, FL 33950

PROJECT CONTACT
NAME: DOUG SLOAN
PHONE: (941) 815-6235

PROJECT:
THE VISTAS AT GULF SHORE BLVD
4651 GULF SHORE BLVD.
NAPLES, FL 34103

CLIENT:



CONTACT: GREG SHAVALIER


ORIGINAL DRAWING DATE

7/10/26

DRAWING REVISIONS

△	
△	
5.0

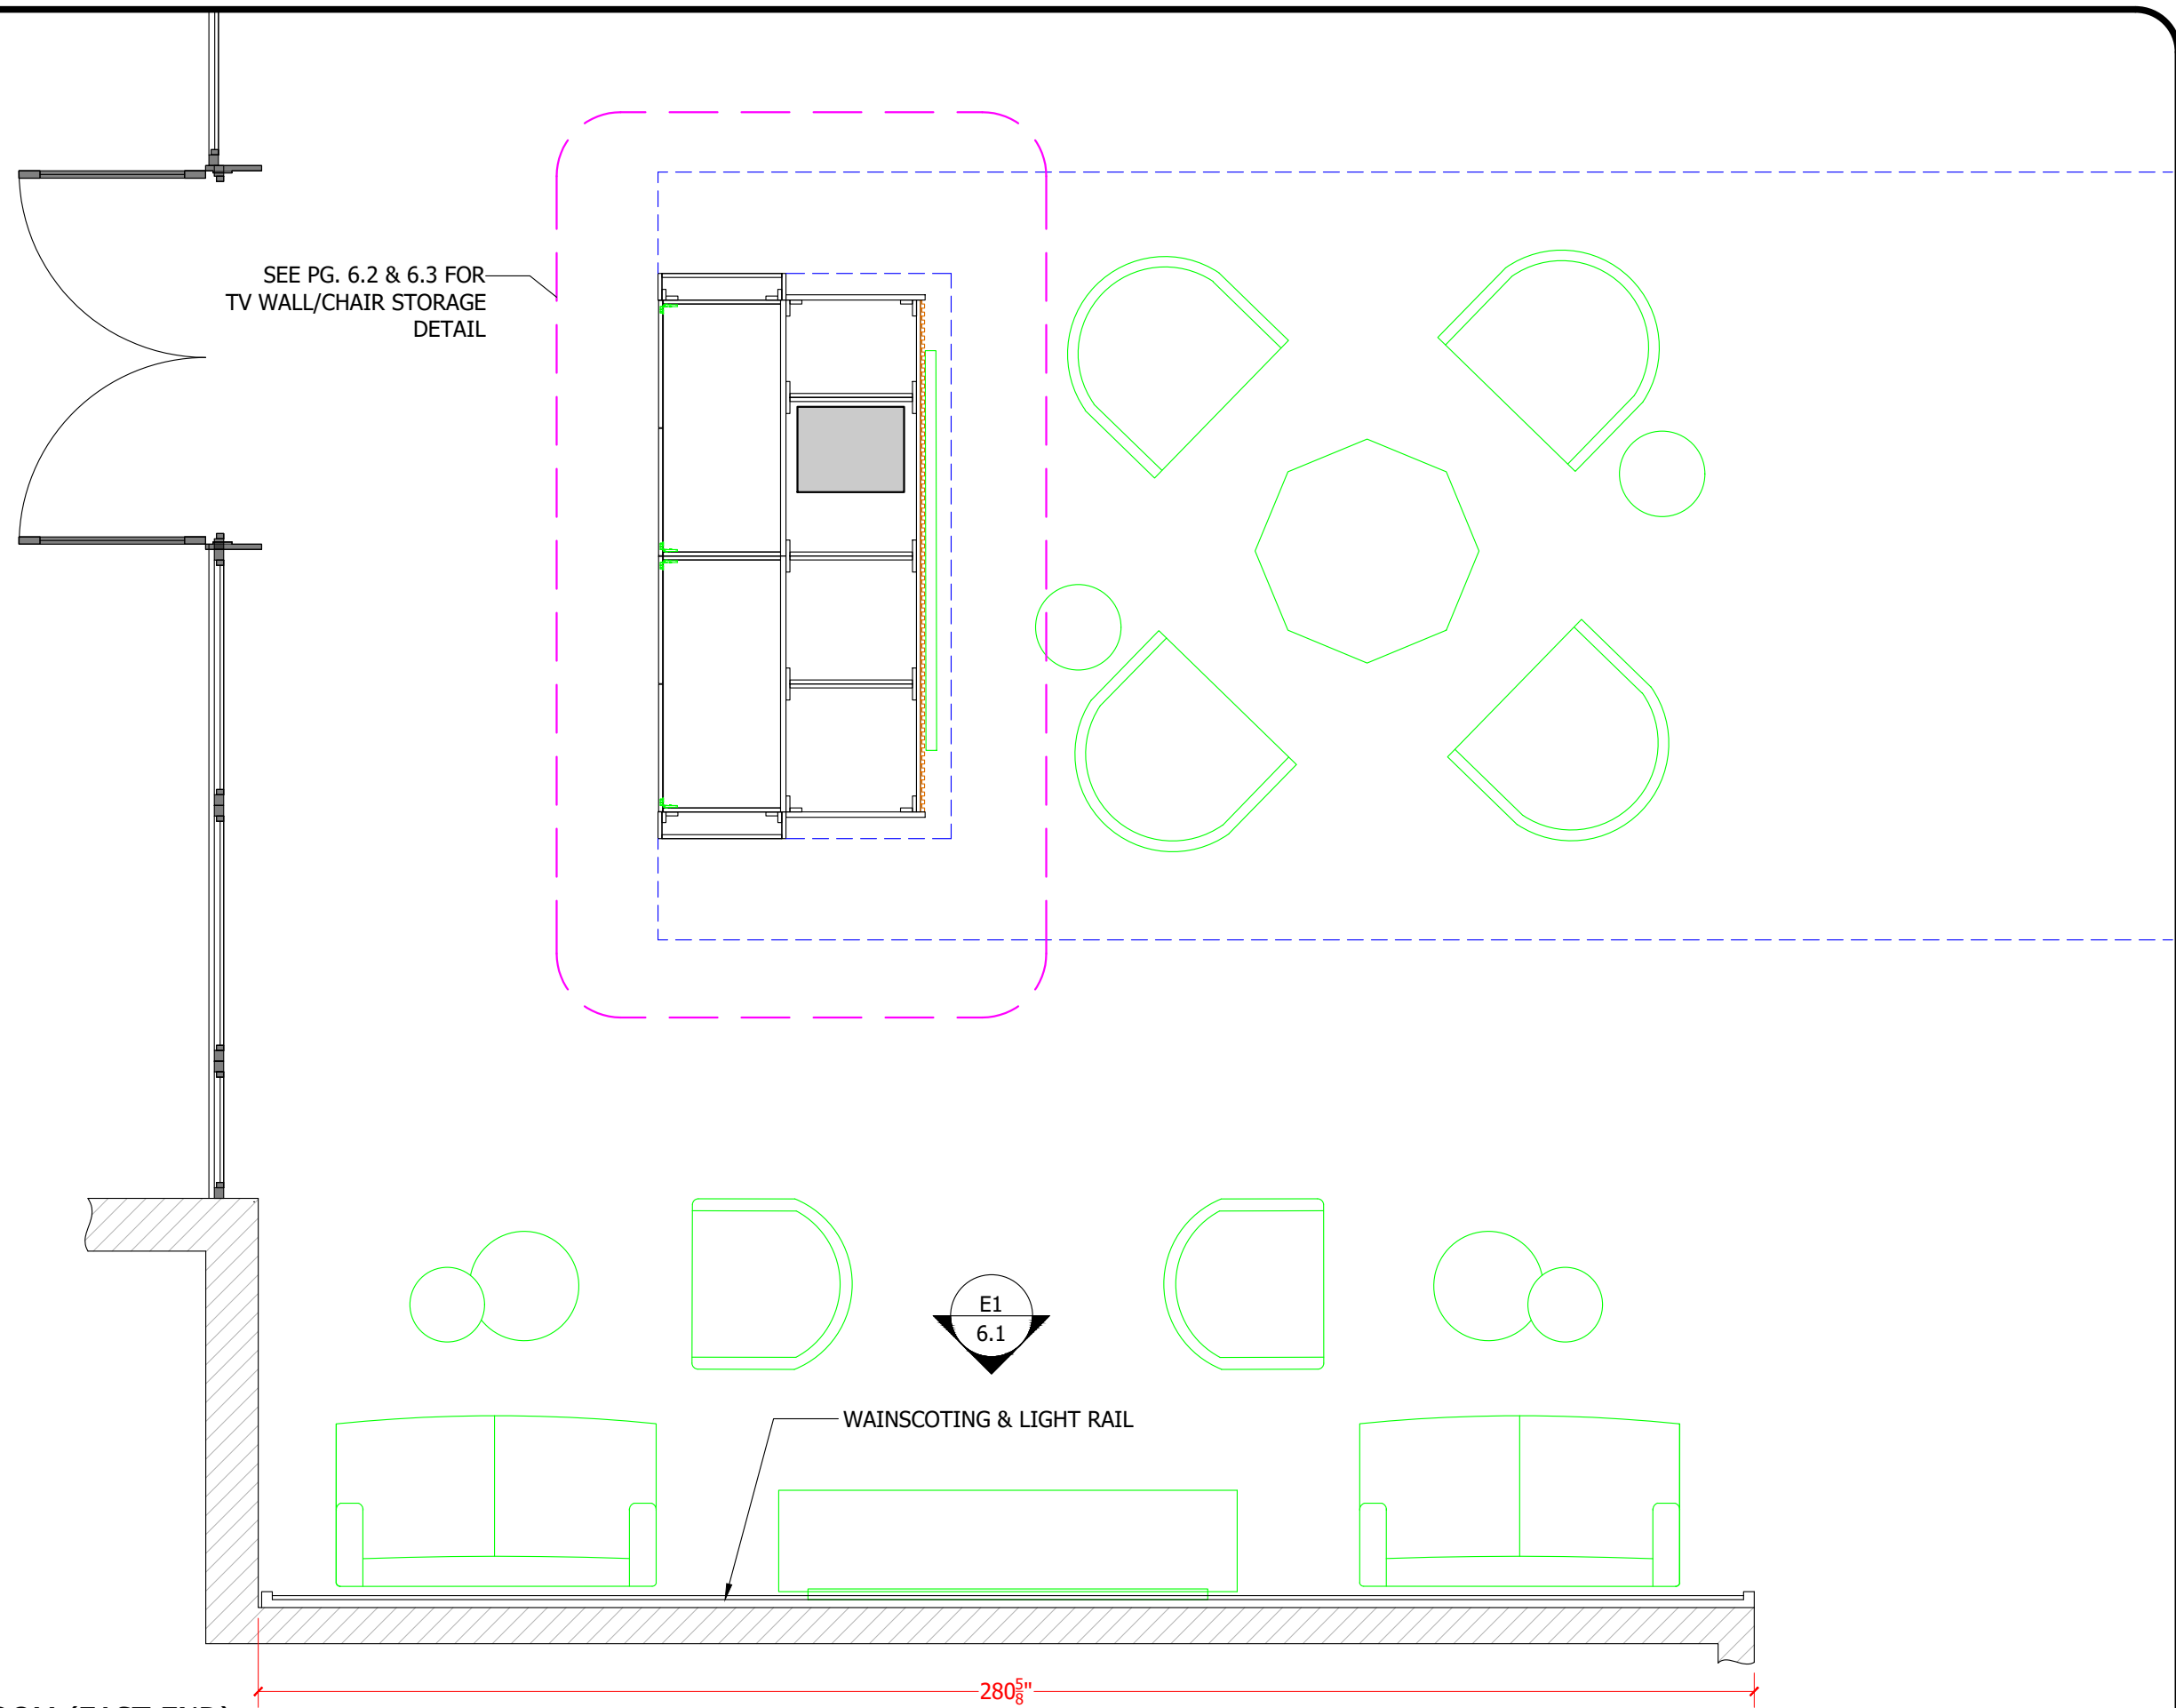

6 SOCIAL ROOM (EAST END)
Scale: 3/8"=1'-0"



JOHN JEWELL
CRAFTER OF FINE CABINETS & MILLWORK

25550 TECHNOLOGY BLVD
PUNTA GORDA, FL 33950

PROJECT CONTACT
NAME: DOUG SLOAN
PHONE: (941) 815-6235

PROJECT:
THE VISTAS AT GULF SHORE BLVD
4651 GULF SHORE BLVD.
NAPLES, FL 34103

CLIENT:




BLUE HORIZON
CONSTRUCTION


CONTACT: GREG SHAVALIER

ORIGINAL DRAWING DATE	
7/10/26	
DRAWING REVISIONS	
△	
△	
6.0

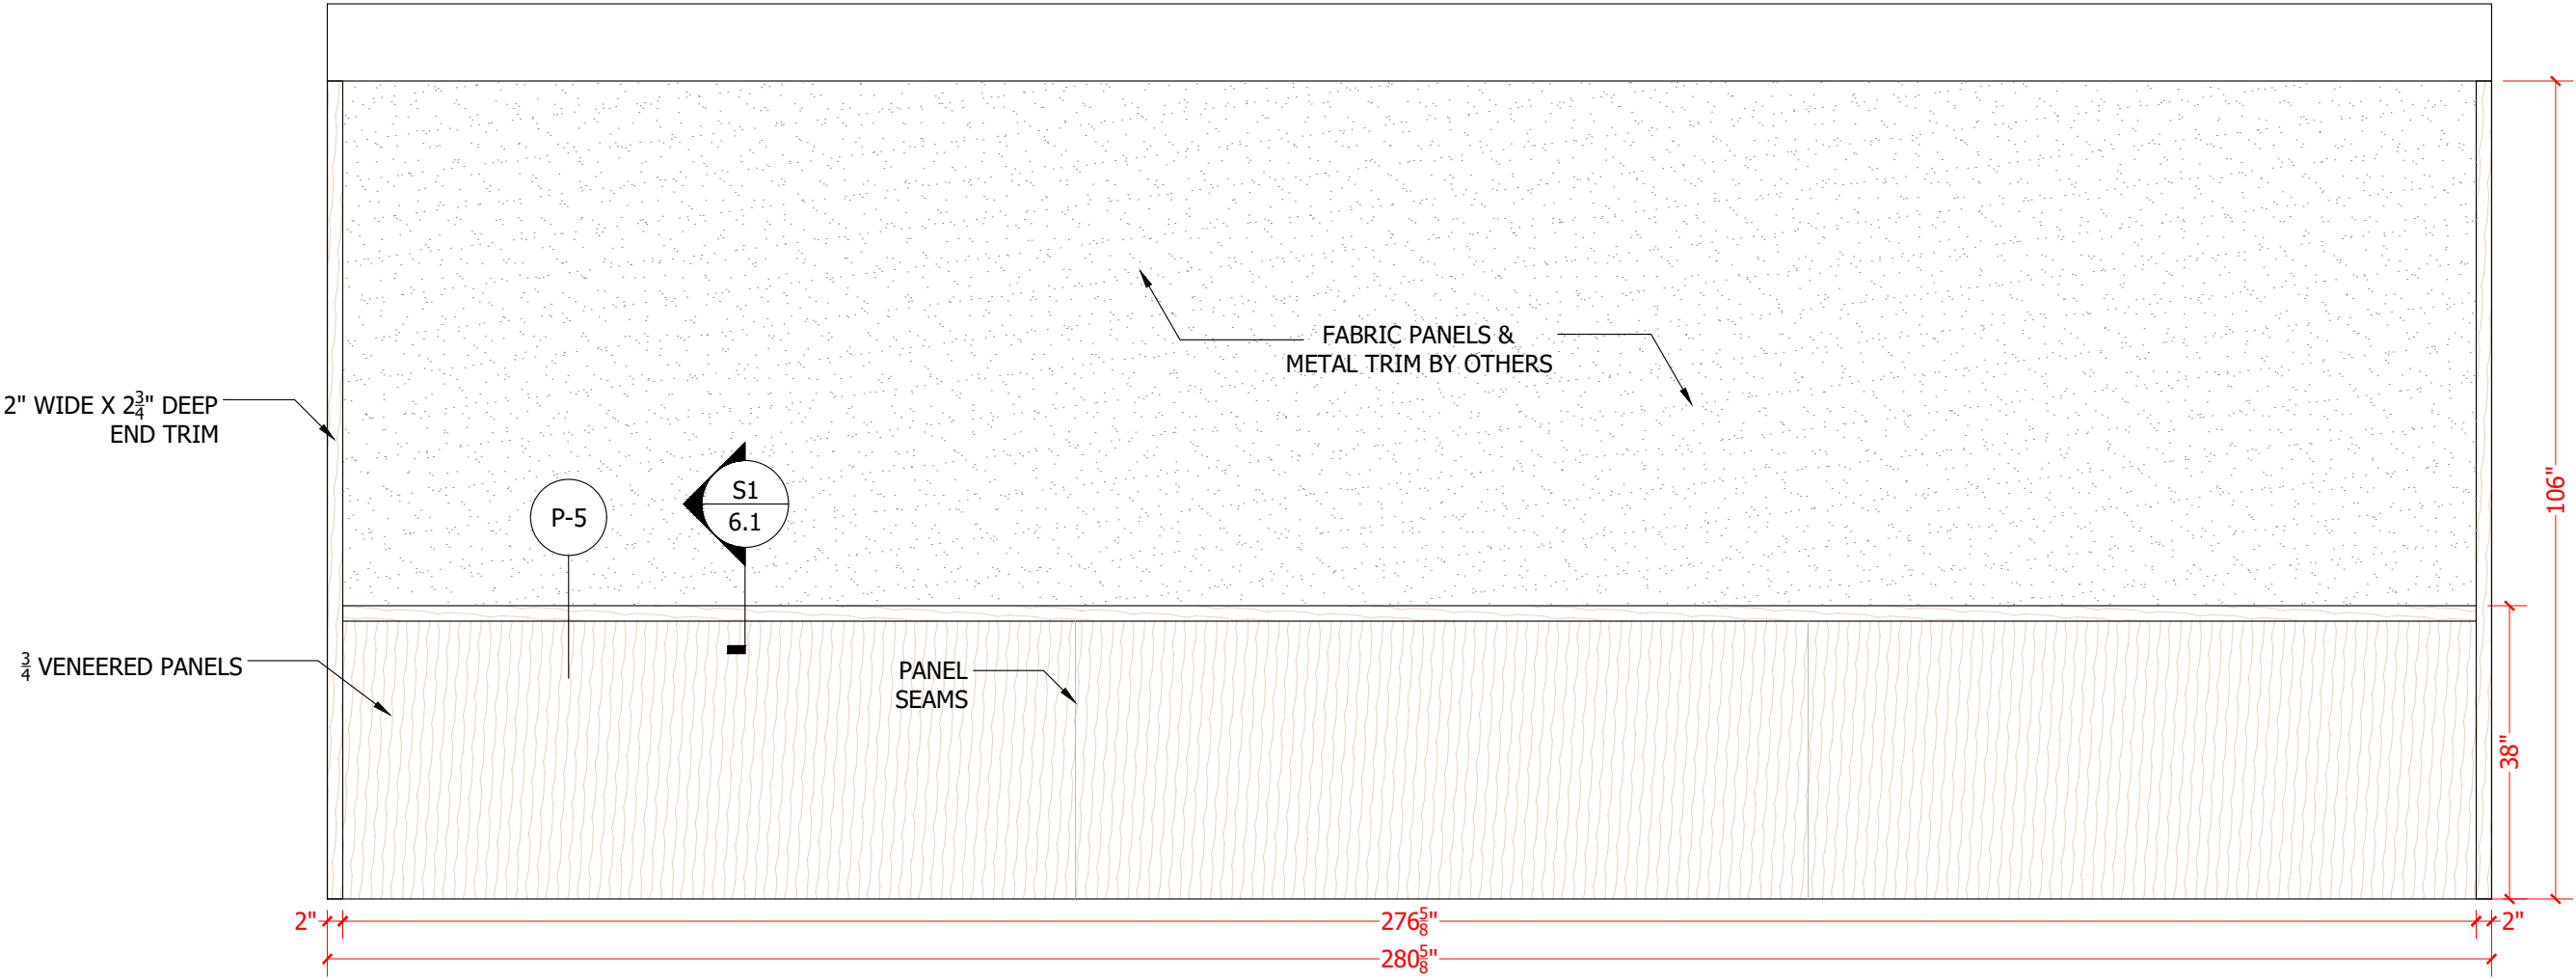

E1 SOCIAL ROOM (EAST END)
Scale: 1/2"=1'-0"

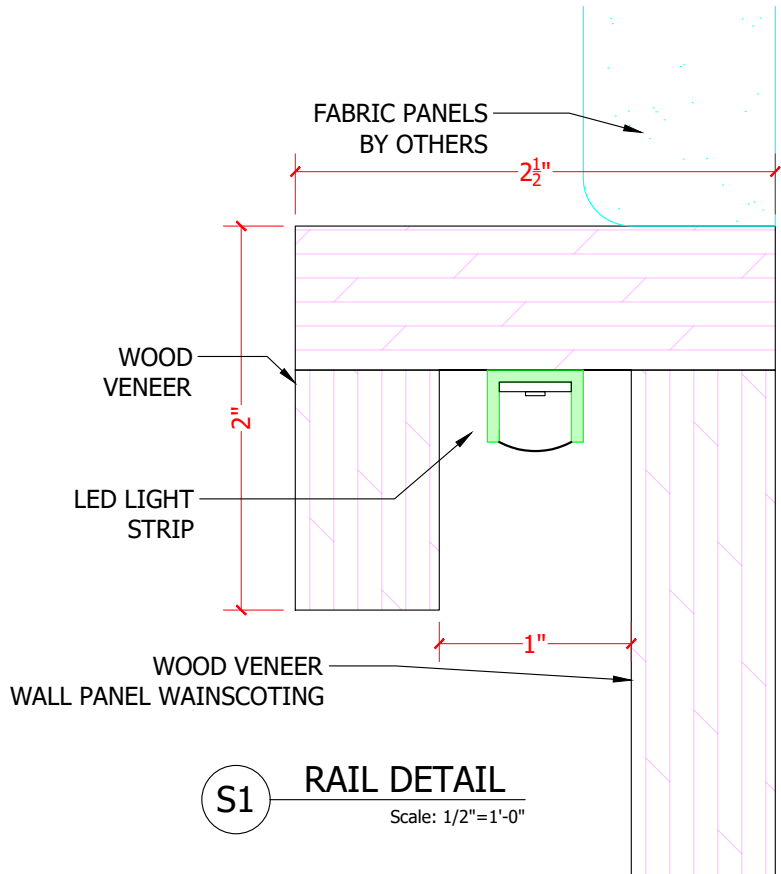

S1 RAIL DETAIL
Scale: 1/2"=1'-0"

CASEWORK FINISHES:
(P-5) MAPLE VENEER STAINED TO MATCH "CHARRED CLAY"



JOHN JEWELL

CRAFTER OF FINE CABINETRY & MILLWORK

25550 TECHNOLOGY BLVD
PUNTA GORDA, FL 33950

PROJECT CONTACT
NAME: DOUG SLOAN
PHONE: (941) 815-6235

PROJECT:
THE VISTAS AT GULF SHORE BLVD
4651 GULF SHORE BLVD.
NAPLES, FL 34103

CLIENT:



CONTACT: GREG SHAVALIER

ORIGINAL DRAWING DATE	
7/10/26	
DRAWING REVISIONS	
△	
△	
6.1

PROJECT:
THE VISTAS AT GULF SHORE BLVD
4651 GULF SHORE BLVD.
NAPLES, FL 34103

CLIENT:



CONTACT: GREG SHAVALIER




ORIGINAL DRAWING DATE

7/10/26


DRAWING REVISIONS

△	
△	
6.2

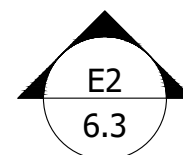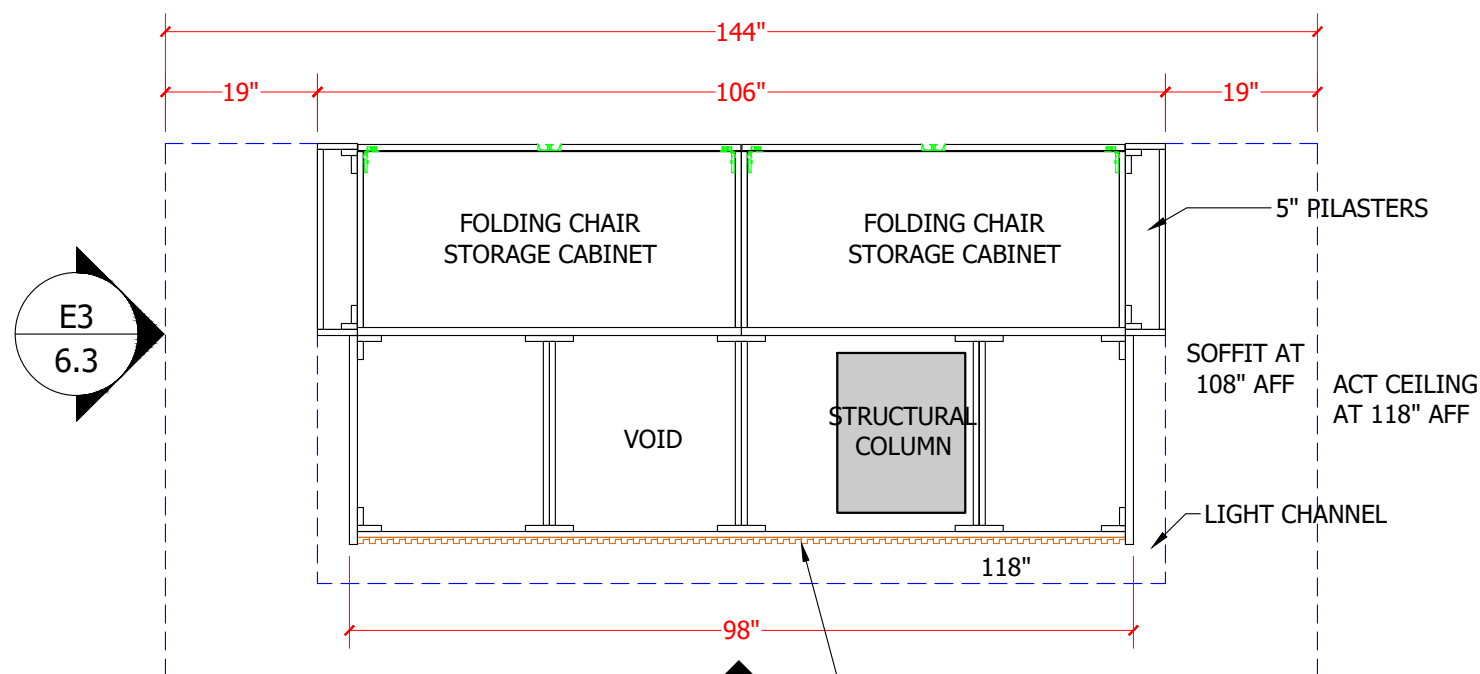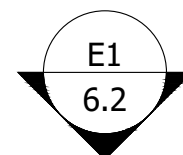


D1 TV WALL/CHAIR STORAGE
Scale: 1/2"=1'-0"

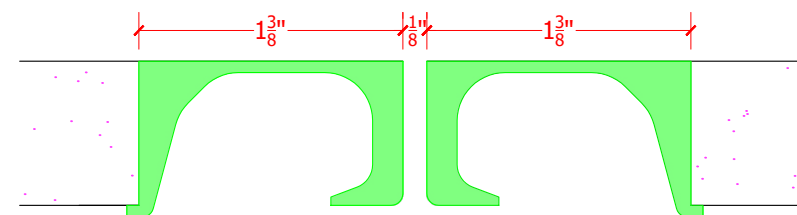

D1 FINGER PULL DETAIL
Scale: 1:1
SEE PG CS-4 FOR DETAIL

CASEWORK FINISHES:
(P-6) MAPLE VENEER STAINED TO MATCH "PHANTOM COCOA"
(P-7) OAK VENEER STAINED TO MATCH "BEIGEWOOD"
(P-4) SW 7570 EGRET WHITE / SATIN
(P-2) SW 7005 PURE WHITE / FLAT

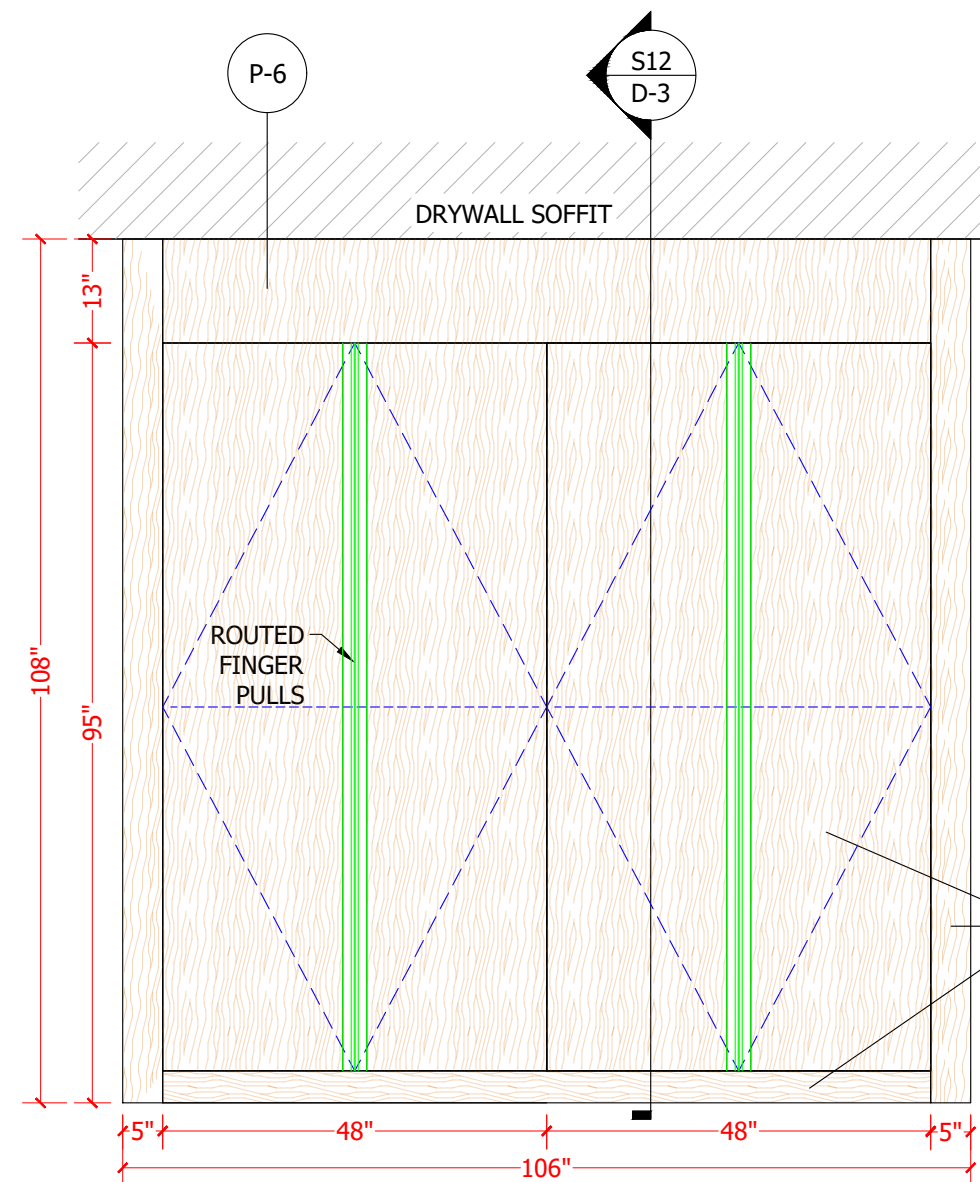

E1 CHAIR STORAGE
Scale: 1/2"=1'-0"

HATCH INDICATES
VENEER GRAIN
DIRECTION

PROJECT:
THE VISTAS AT GULF SHORE BLVD
4651 GULF SHORE BLVD.
NAPLES, FL 34103

CLIENT:




BLUE HORIZON
— CONSTRUCTION —

CONTACT: GREG SHAVALIER

ORIGINAL DRAWING DATE	
7/10/26	
DRAWING REVISIONS	
1	
2	
3	
4	
5	
6	
7	


6.3

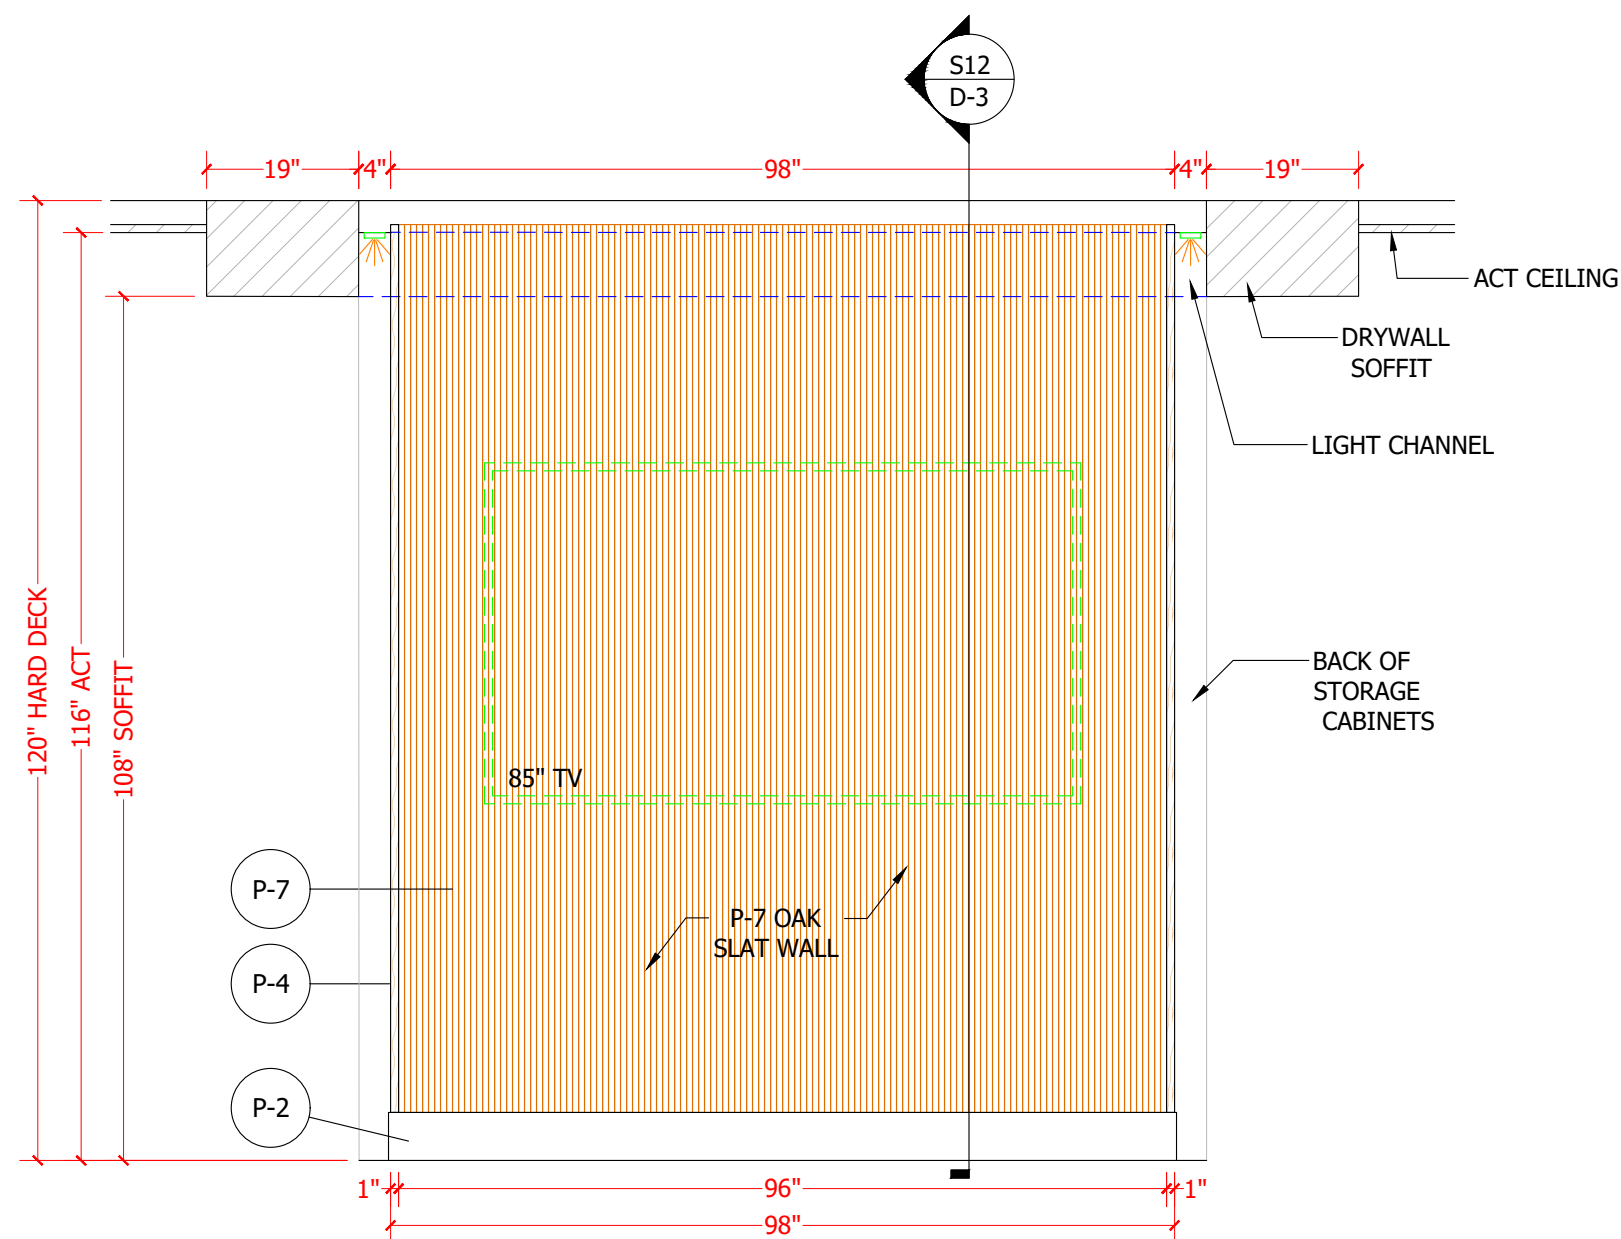

E2 TV FEATURE WALL
Scale: 1/2"=1'-0"


CASEWORK FINISHES:
(P-6) MAPLE VENEER STAINED TO MATCH "PHANTOM COCOA"
(P-7) OAK VENEER STAINED TO MATCH "BEIGEWOOD"
(P-4) SW 7570 EGRET WHITE / SATIN
(P-2) SW 7005 PURE WHITE / FLAT

PLEASE VERIFY
SLAT WALL PROFILE

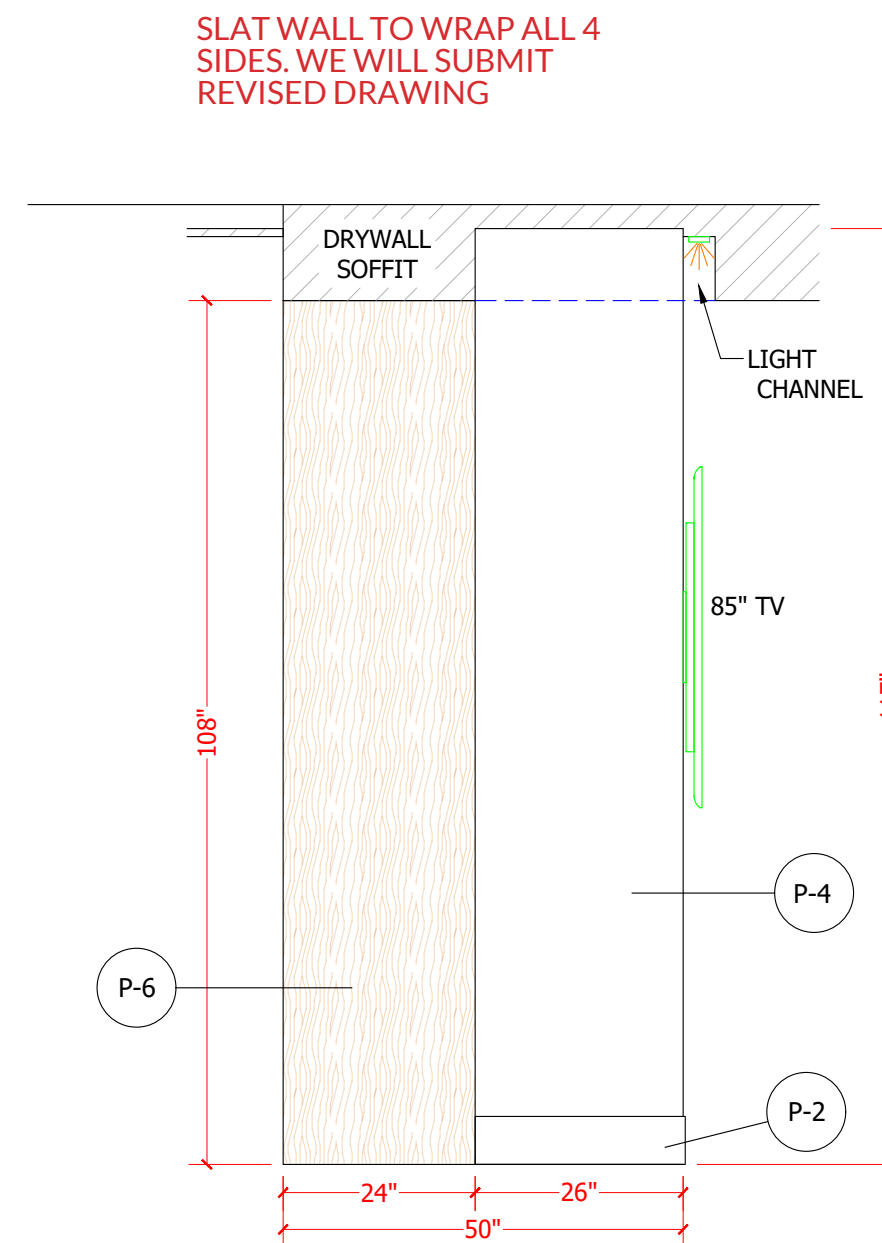


E3 **SIDE VIEW**
Scale: 1/2"=1'-0"

HATCH INDICATES
VENEER GRAIN
DIRECTION

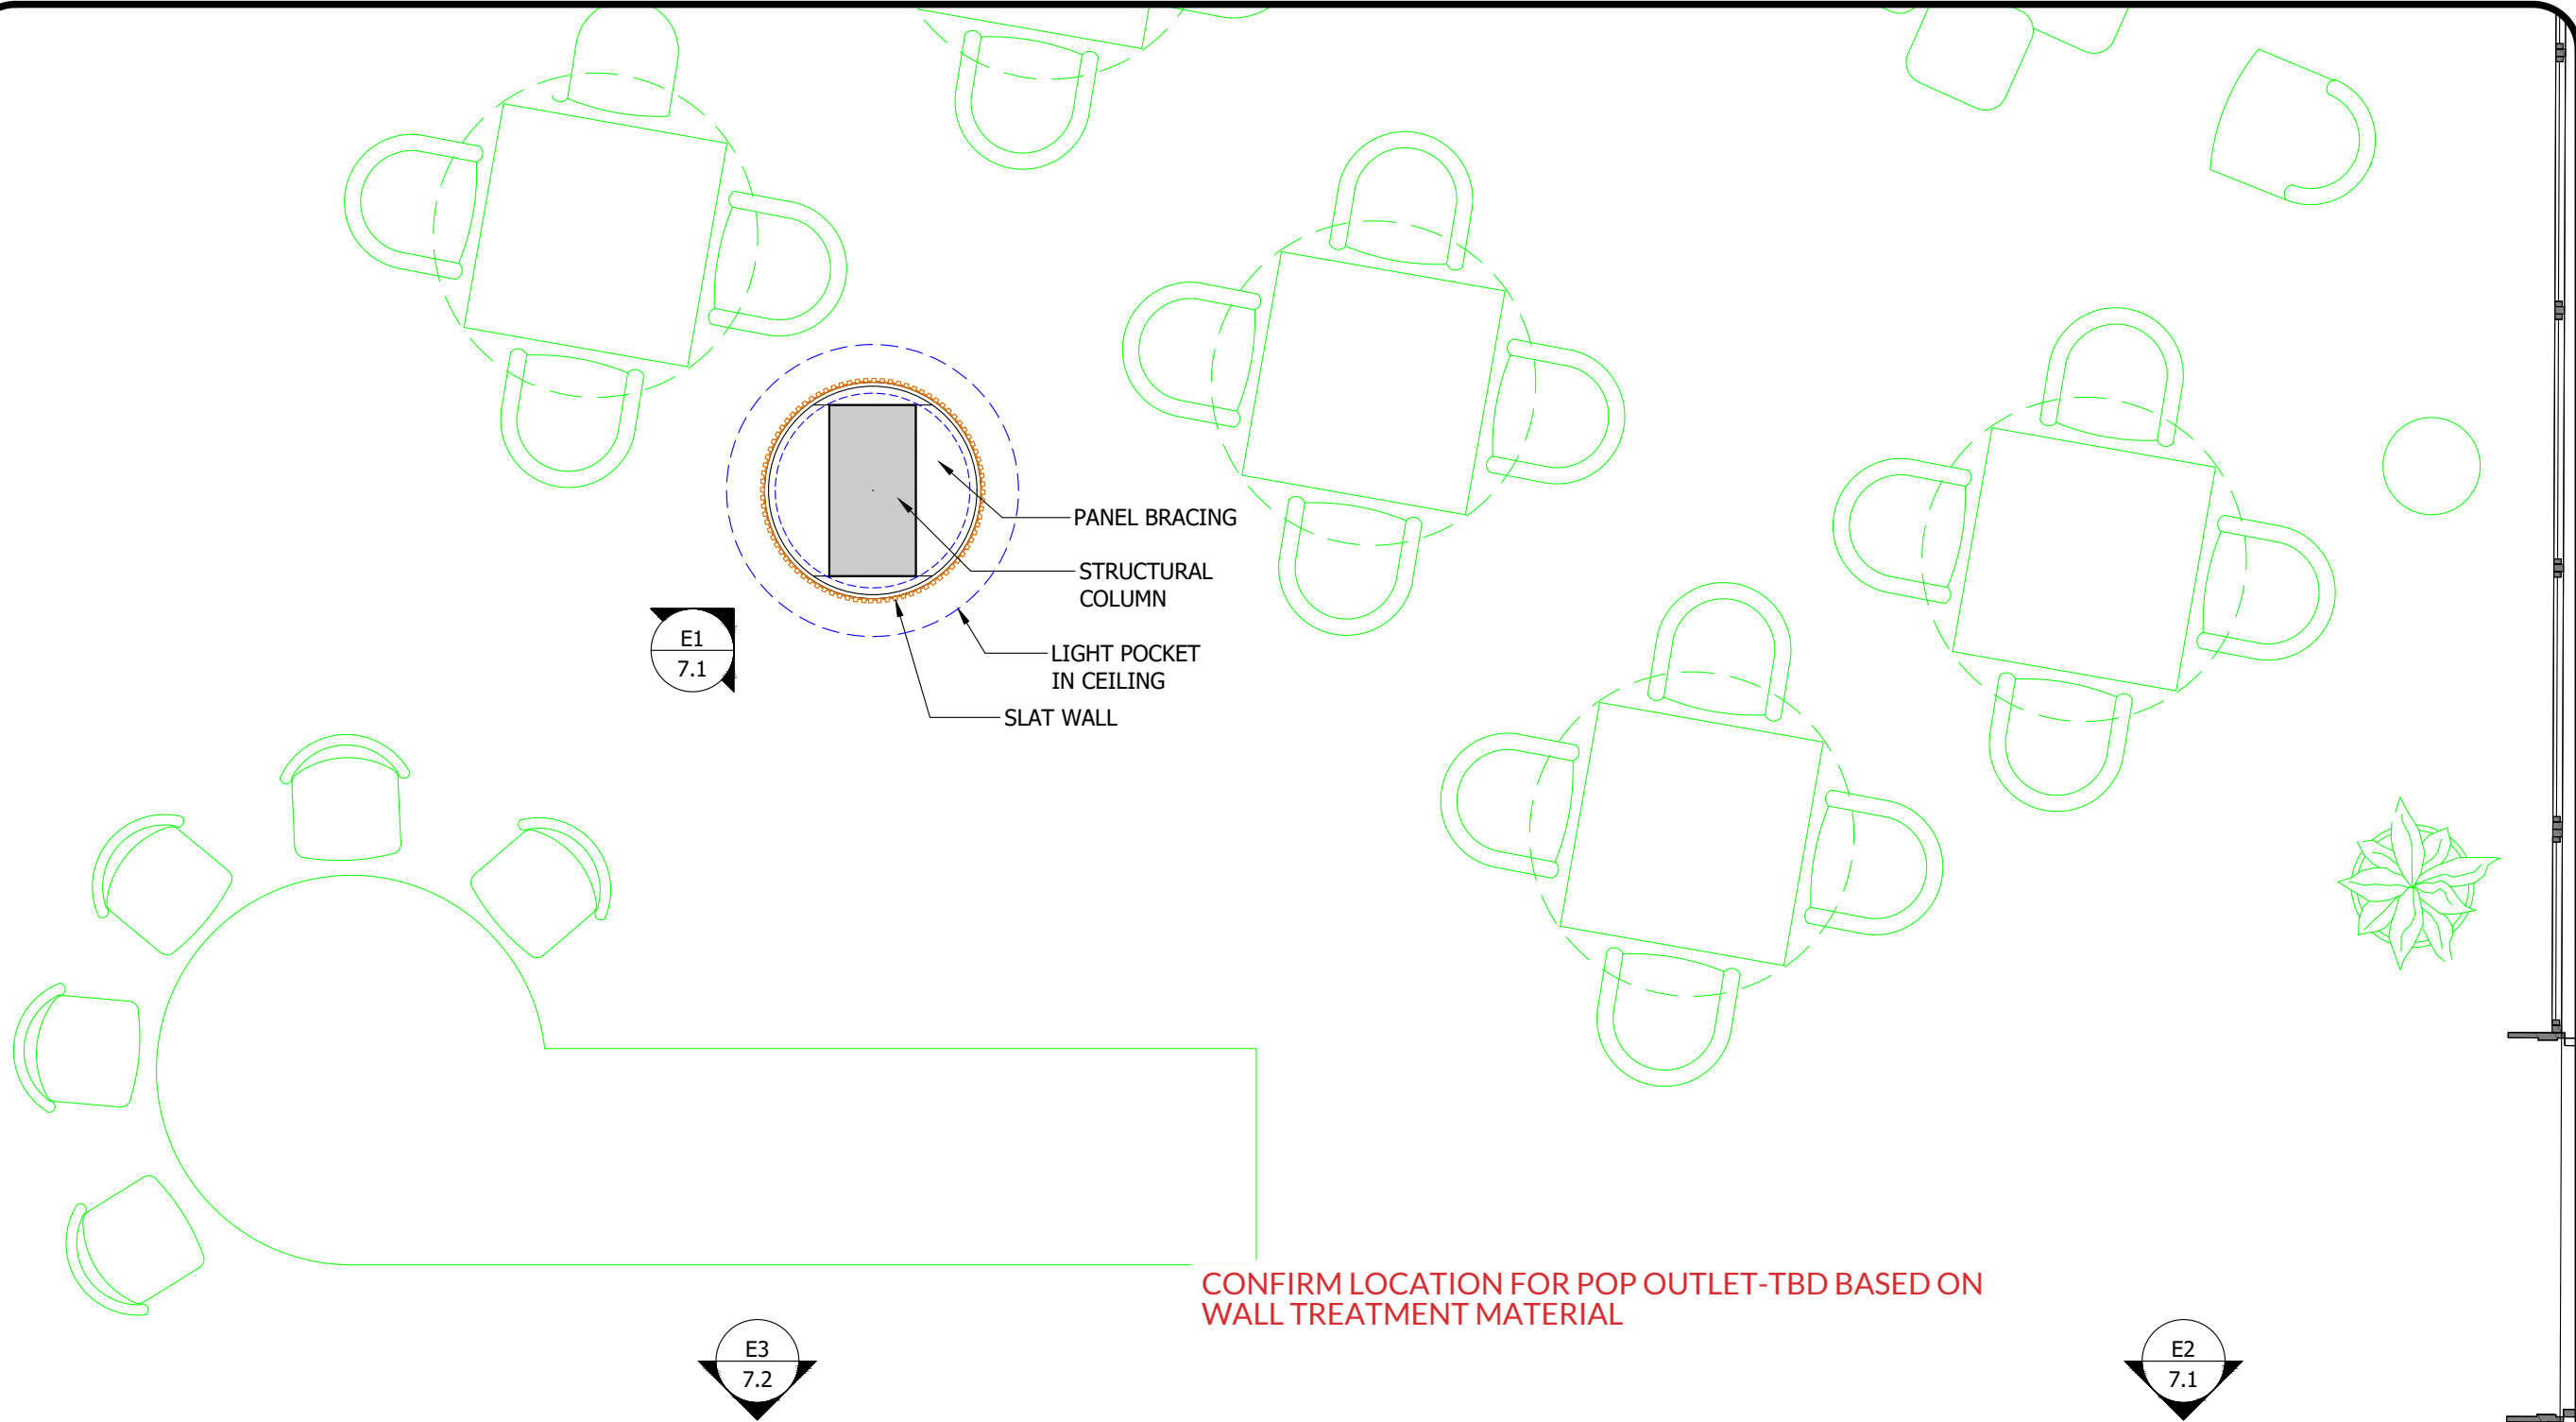

CONFIRM LOCATION FOR POP OUTLET-TBD BASED ON WALL TREATMENT MATERIAL

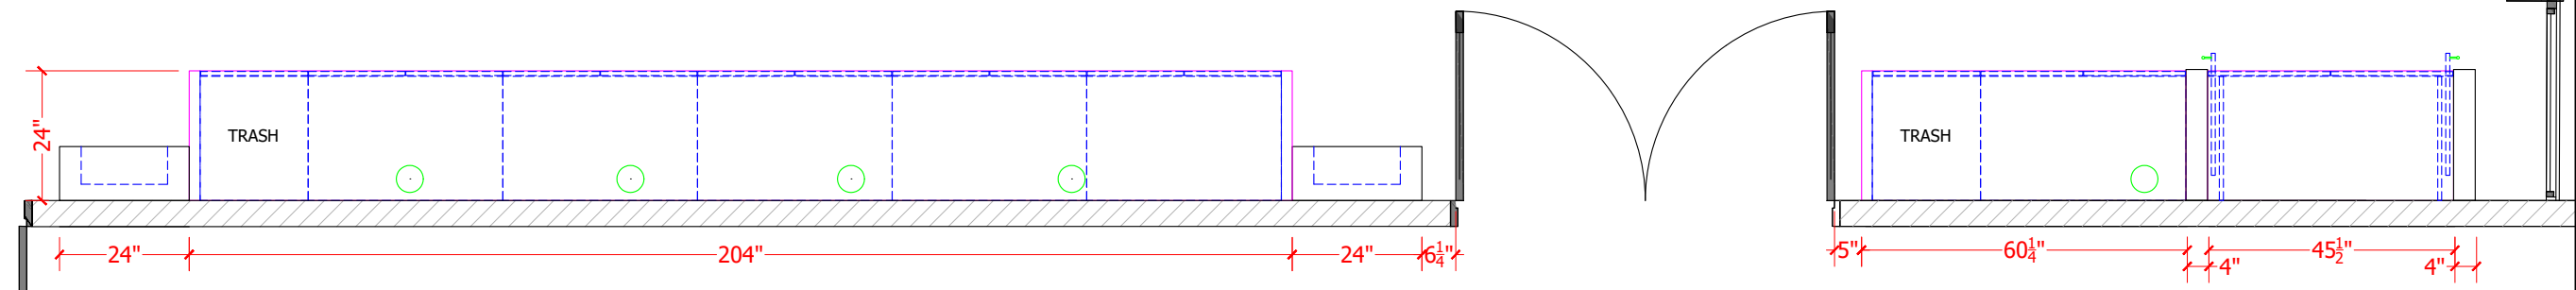



JOHN JEWELL
CRAFTER OF FINE CABINETS & MILLWORK

25550 TECHNOLOGY BLVD
PUNTA GORDA, FL 33950

PROJECT CONTACT
NAME: DOUG SLOAN
PHONE: (941) 815-6235

PROJECT:
THE VISTAS AT GULF SHORE BLVD
4651 GULF SHORE BLVD.
NAPLES, FL 34103

CLIENT:



BLUE HORIZON
CONSTRUCTION


CONTACT: GREG SHAVALIER

ORIGINAL DRAWING DATE	
7/10/26	
DRAWING REVISIONS	
△	
△	
PROJECT:
THE VISTAS AT GULF SHORE BLVD
4651 GULF SHORE BLVD.
NAPLES, FL 34103


CLIENT:
 **BLUE HORIZON**
CONSTRUCTION
CONTACT: GREG SHAVALIER

ORIGINAL DRAWING DATE	
7/10/26	
DRAWING REVISIONS	
△	
△	
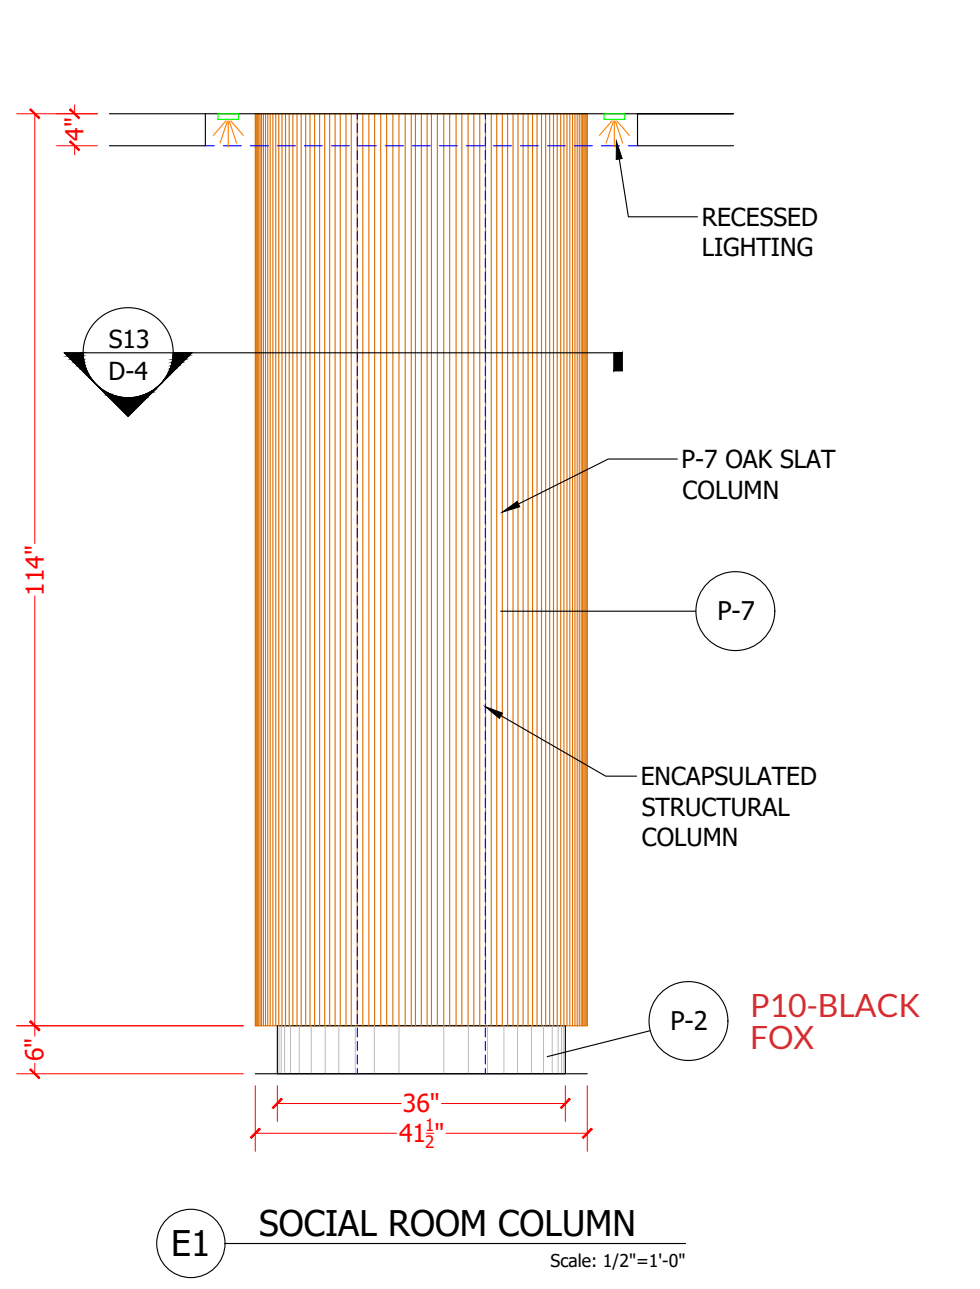

PLEASE VERIFY
SLAT WALL PROFILE

CASEWORK FINISHES:
(P-6) MAPLE VENEER STAINED TO MATCH "PHANTOM COCOA"
(P-7) OAK VENEER STAINED TO MATCH "BEIGEWOOD"
~~(P-2) SW 7005 PURE WHITE / FLAT~~ P10
COUNTERS: STONE BY OTHERS
DECORATIVE HARDWARE: PROVIDED BY OTHERS & INSTALLED BY JJINC.

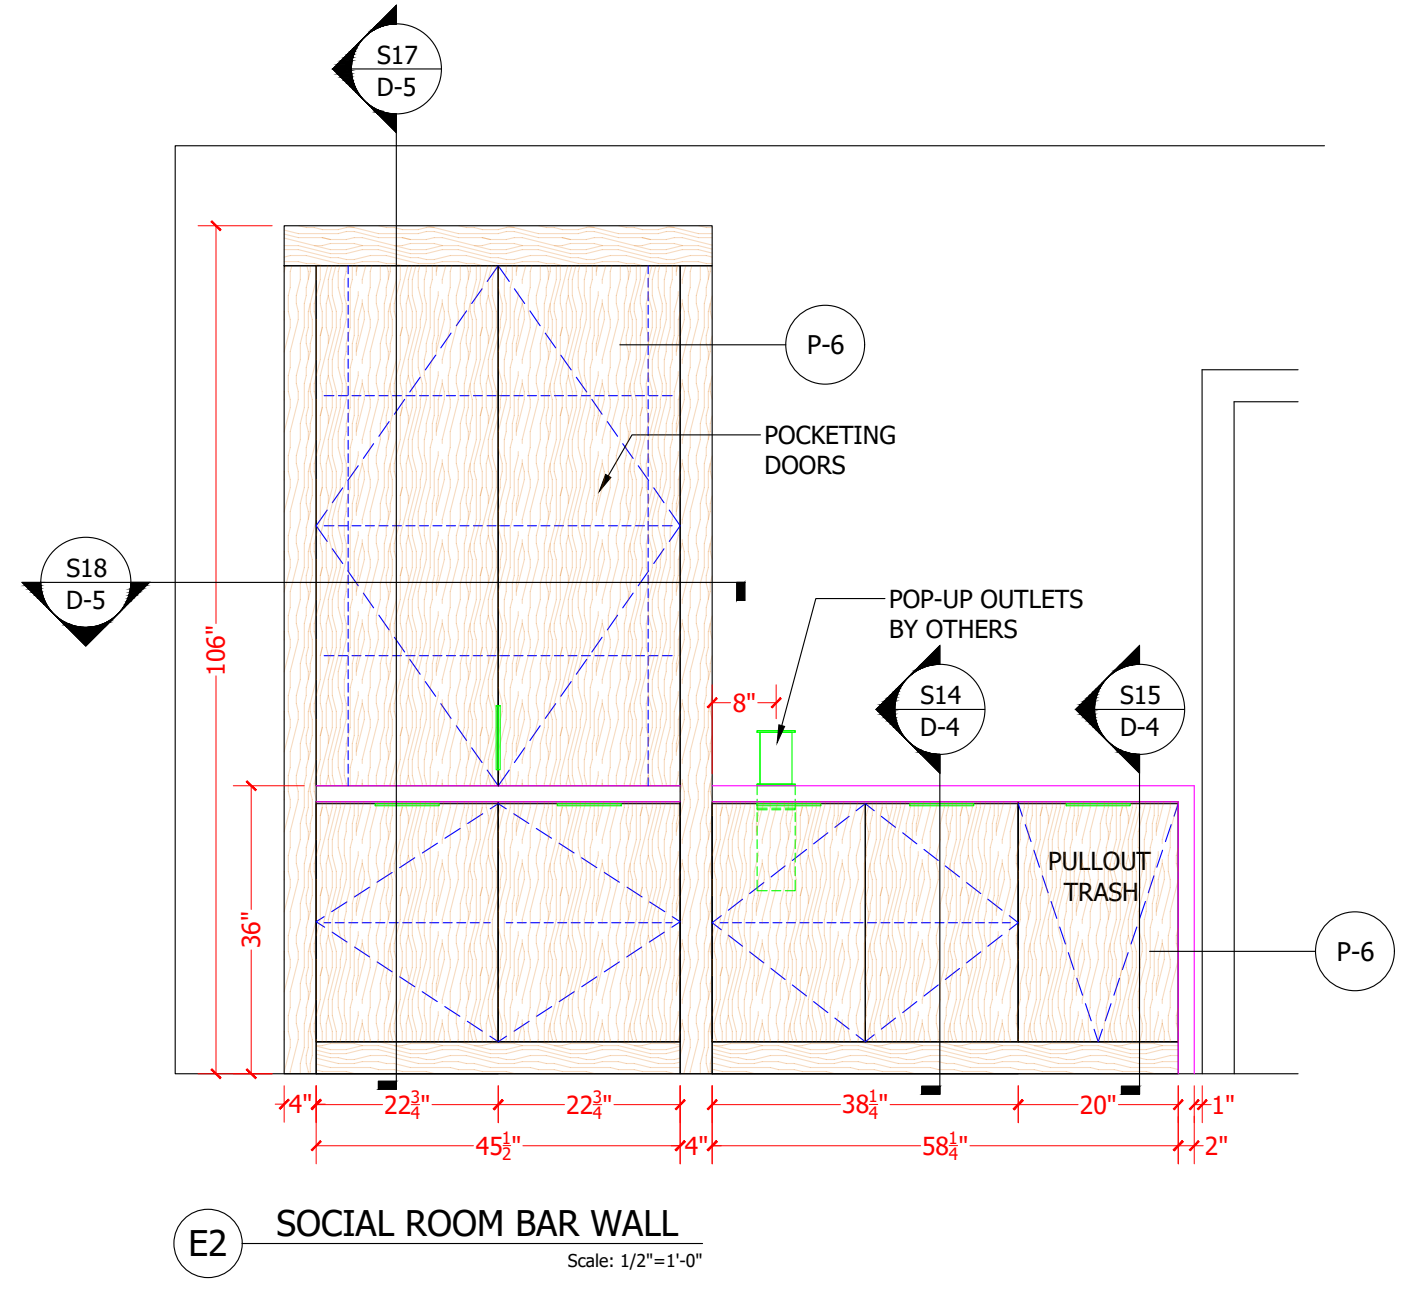

CONFIRM LOCATION FOR POP OUTLET-TBD BASED ON
WALL TREATMENT MATERIAL

HATCH INDICATES
VENEER GRAIN
DIRECTION

PROJECT:
THE VISTAS AT GULF SHORE BLVD
4651 GULF SHORE BLVD.
NAPLES, FL 34103

CLIENT:



CONTACT: GREG SHAVALIER

ORIGINAL DRAWING DATE

7/10/26


DRAWING REVISIONS

△	
△	
HATCH INDICATES
VENEER GRAIN
DIRECTION

7.2

CONFIRM SOFFIT HEIGHT. CABINET TO BE FITTED
UNDERNEATH SOFFIT

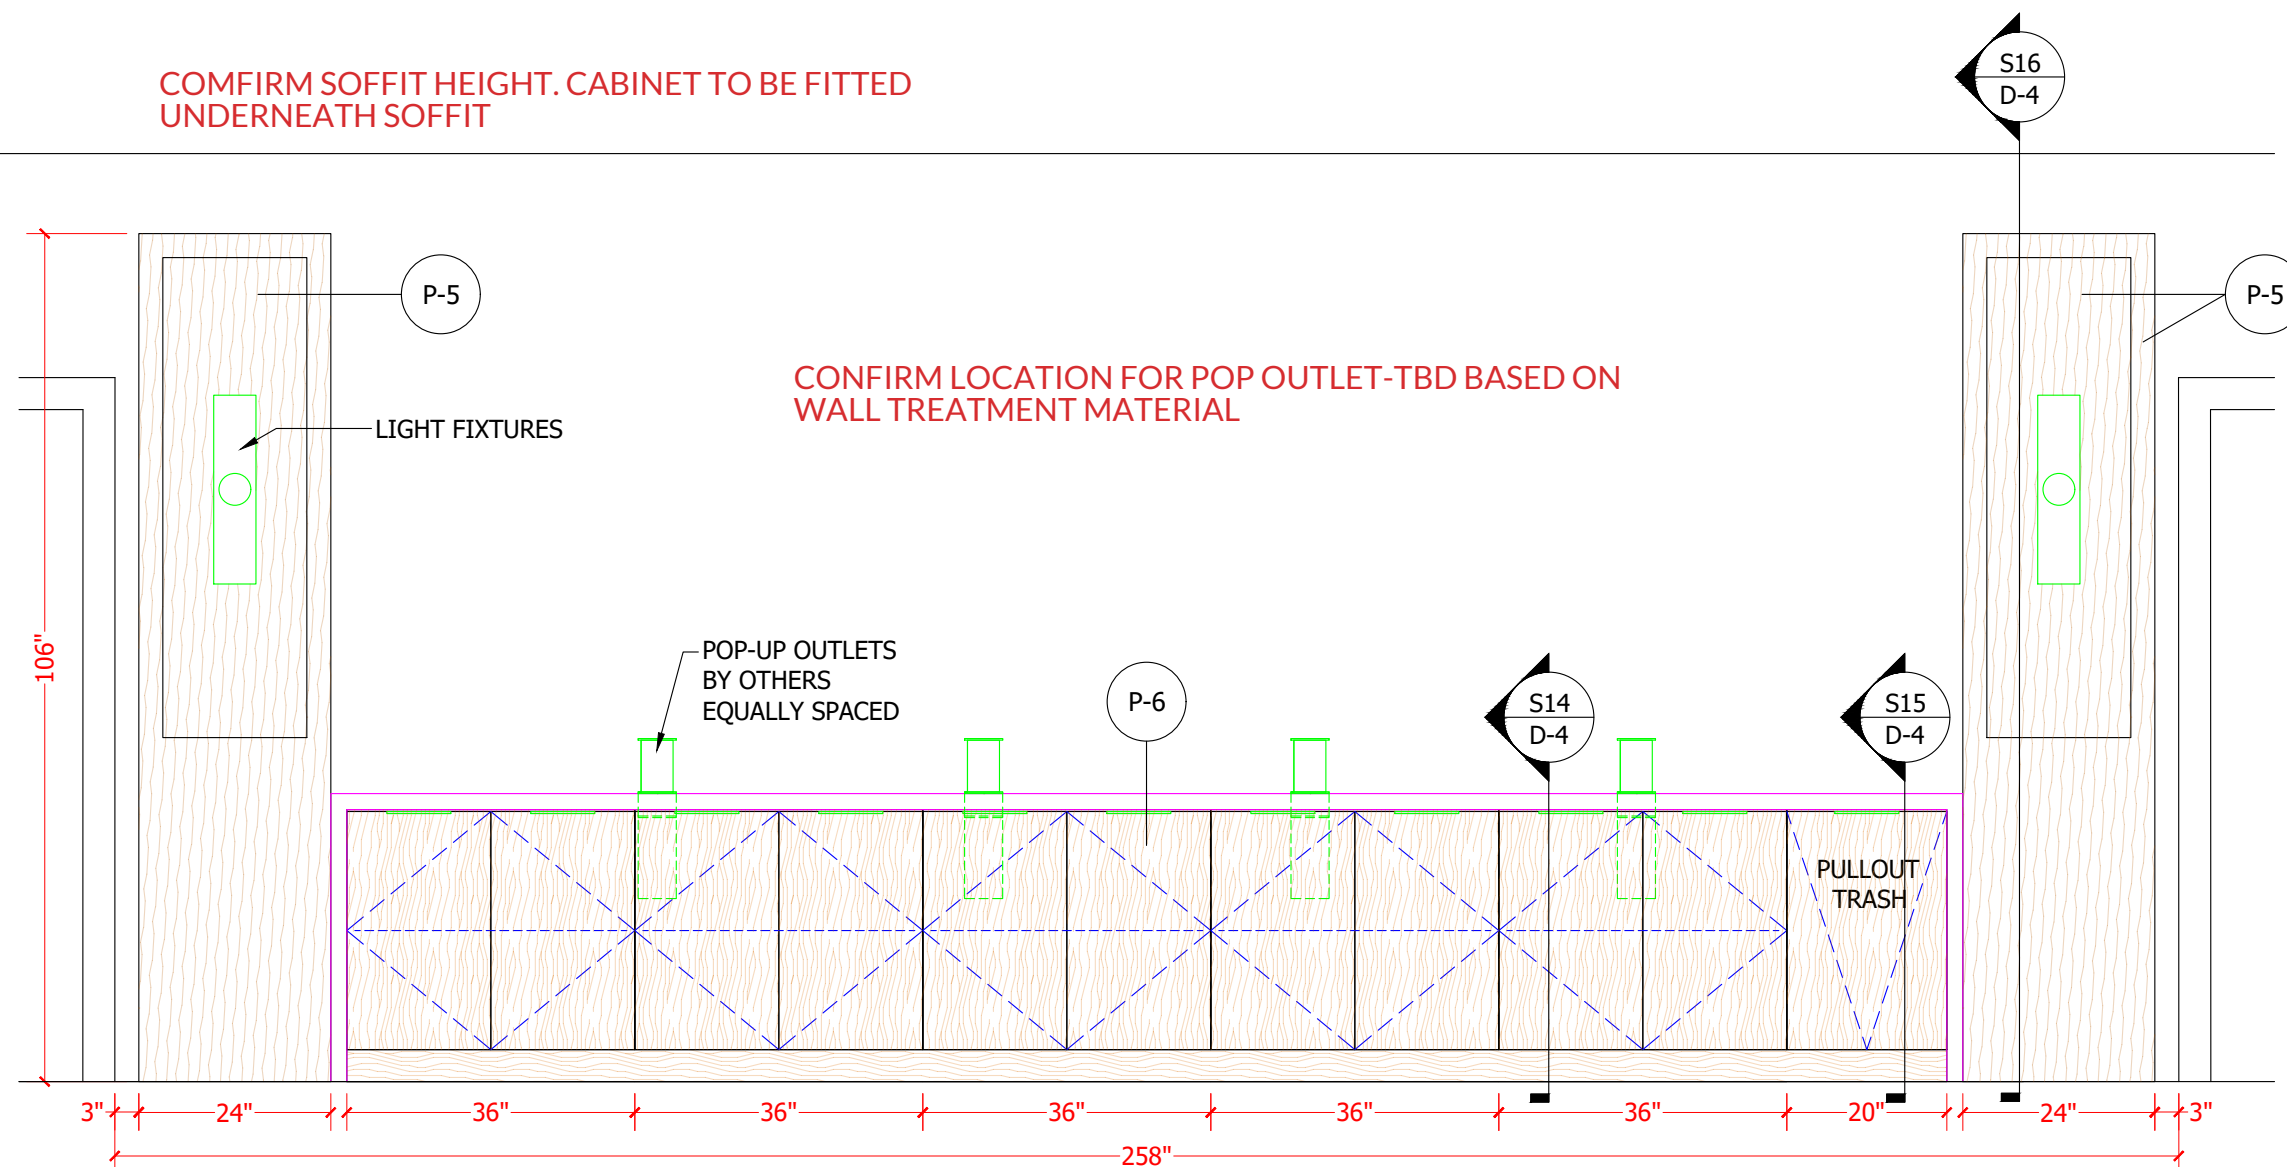

E3 SOCIAL ROOM BAR WALL
Scale: 1/2"=1'-0"

CASEWORK FINISHES:


(P-6) MAPLE VENEER STAINED TO MATCH "PHANTOM COCOA"

(P-7) OAK VENEER STAINED TO MATCH "REDFWOOD"

~~(P-2) SW 7005 PURE WHITE / FLAT~~ **P10**

COUNTERS: STONE BY OTHERS

DECORATIVE HARDWARE: PROVIDED BY OTHERS & INSTALLED BY JJINC.

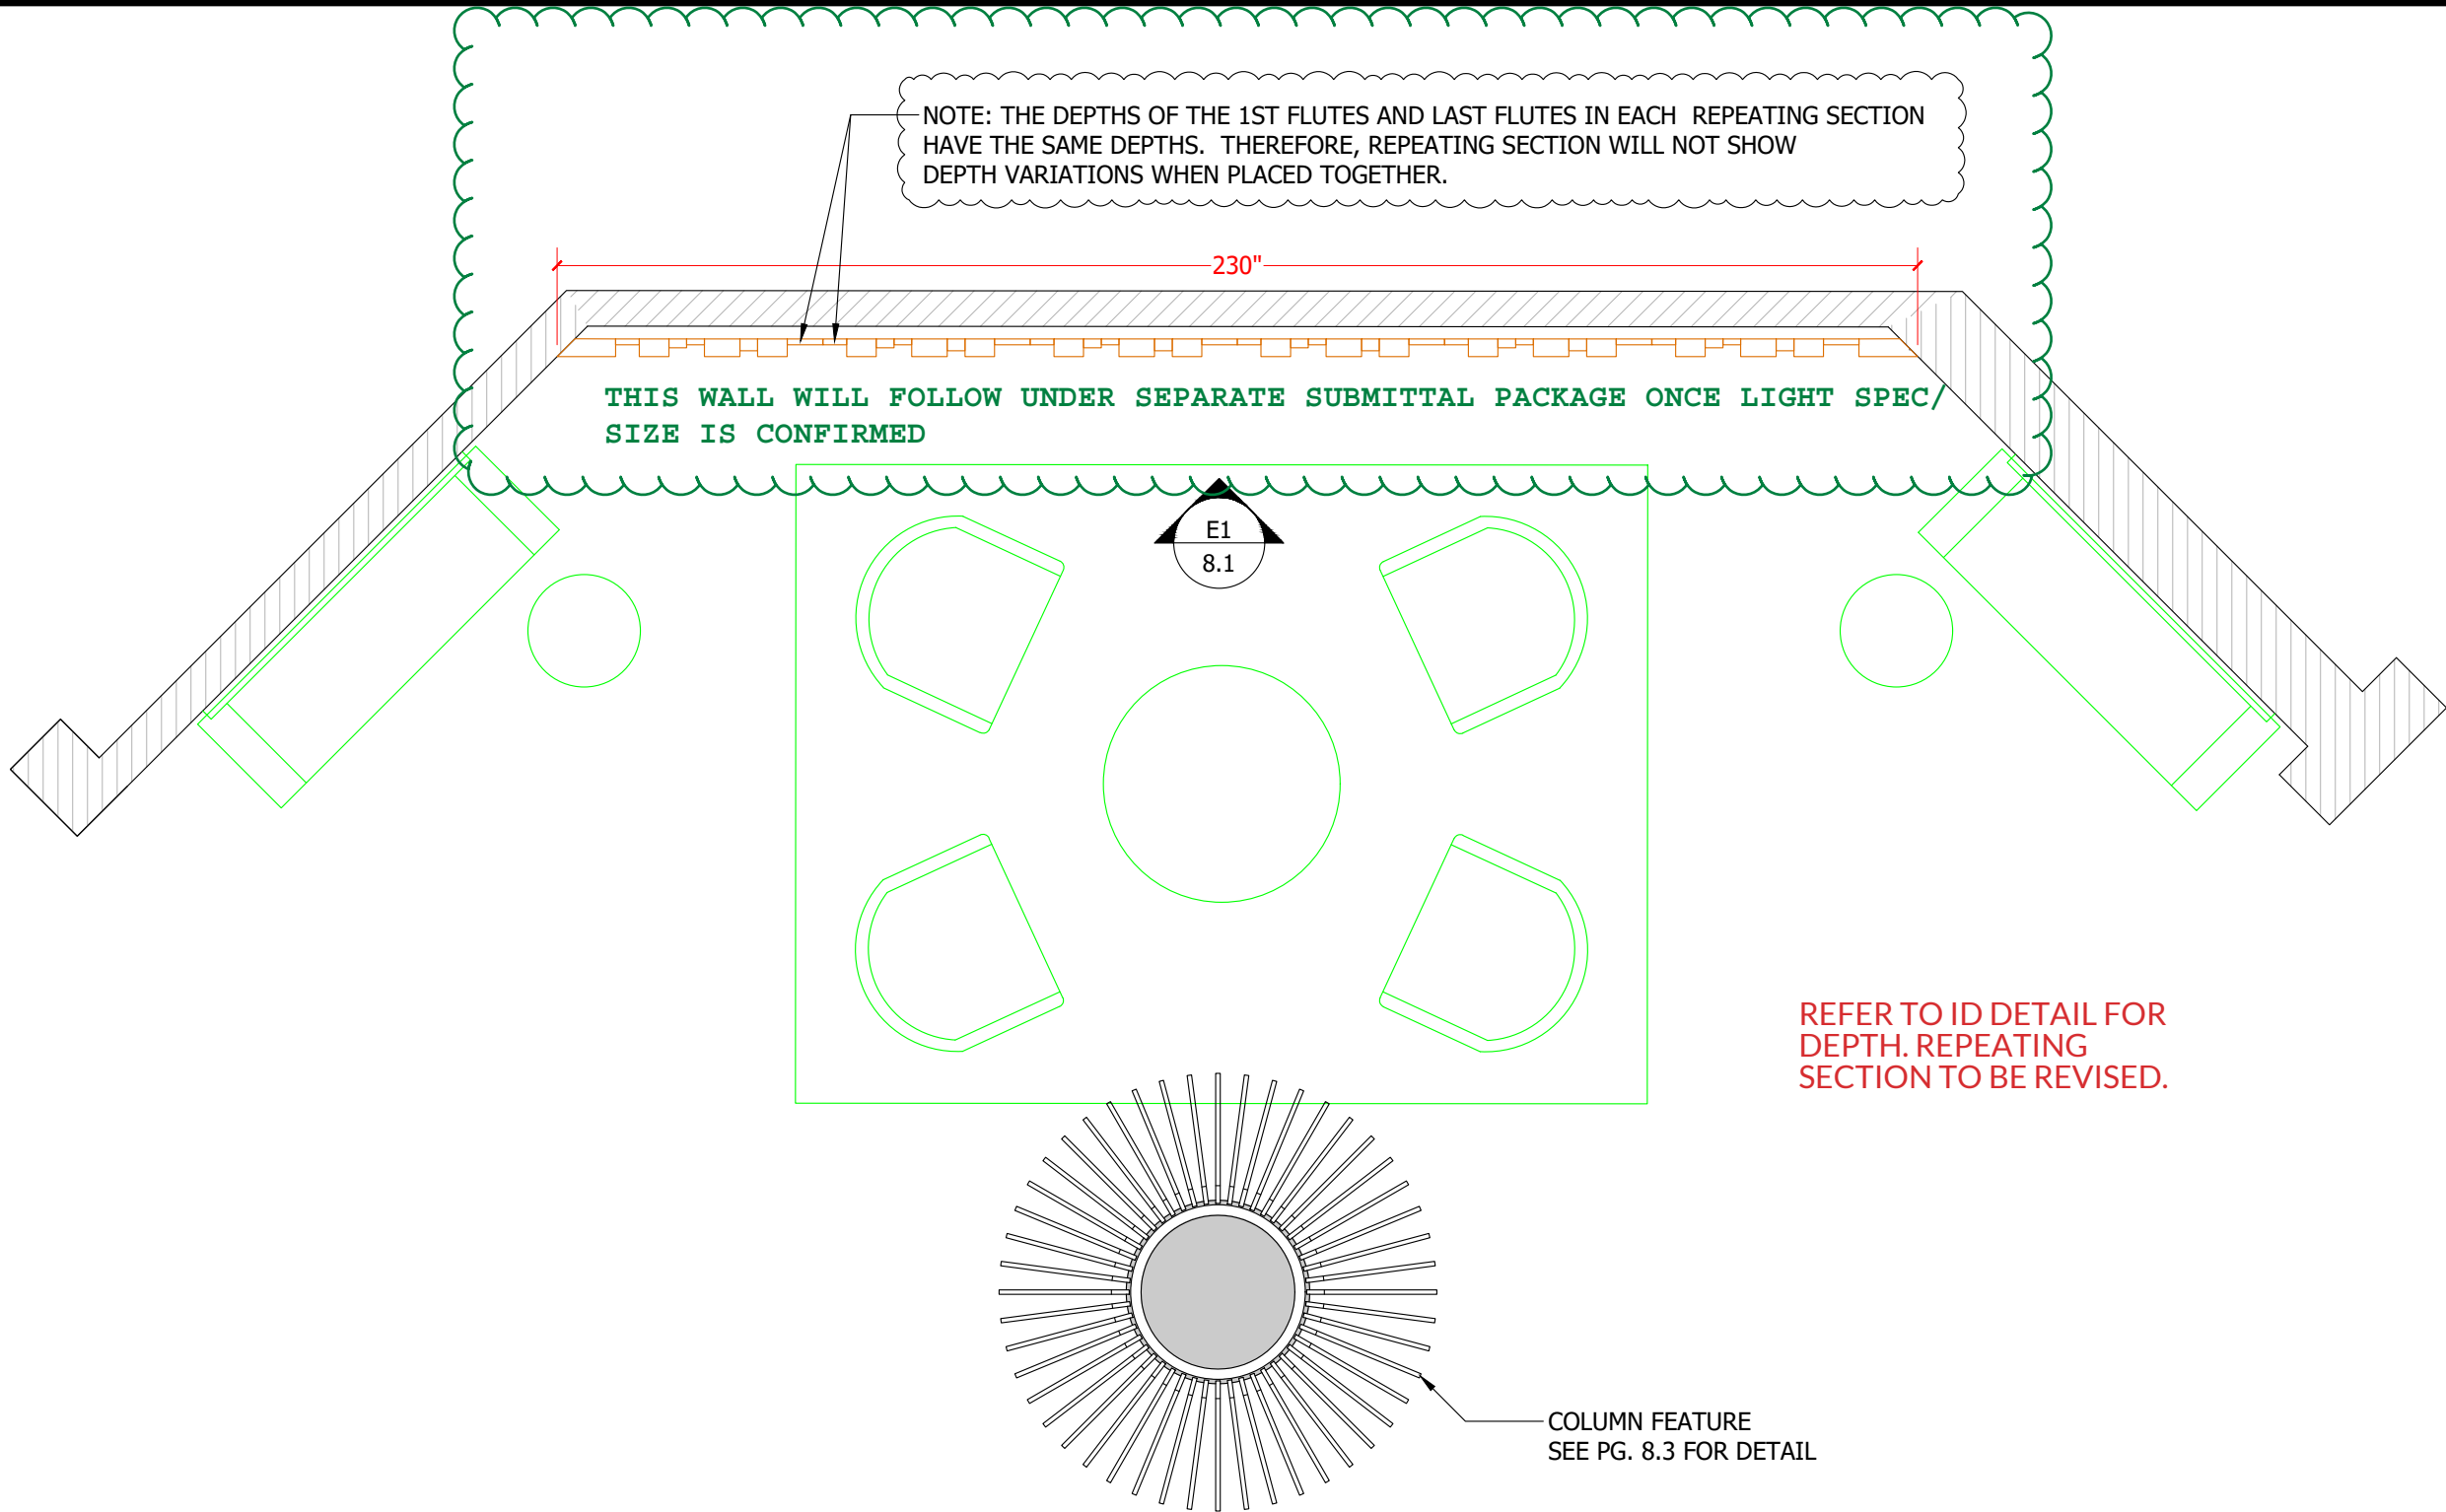

8 WAITING AREA
Scale: 3/8"=1'-0"

PROJECT:
THE VISTAS AT GULF SHORE BLVD
4651 GULF SHORE BLVD.
NAPLES, FL 34103

CLIENT:



CONTACT: GREG SHAVALIER

ORIGINAL DRAWING DATE	
7/10/26	
DRAWING REVISIONS	
△	
△	
PROJECT:
THE VISTAS AT GULF SHORE BLVD
4651 GULF SHORE BLVD.
NAPLES, FL 34103

CLIENT:



CONTACT: GREG SHAVALIER

ORIGINAL DRAWING DATE
7/10/26


DRAWING REVISIONS

△	
△	
8.3

FIELD VERIFY STRUCTURAL COLUMN SIZE
ON SITE AFTER DEMO. LET'S AIM TO MAKE IT
SLIMMER


LED LIGHTING
EMBEDDED IN SOFFIT

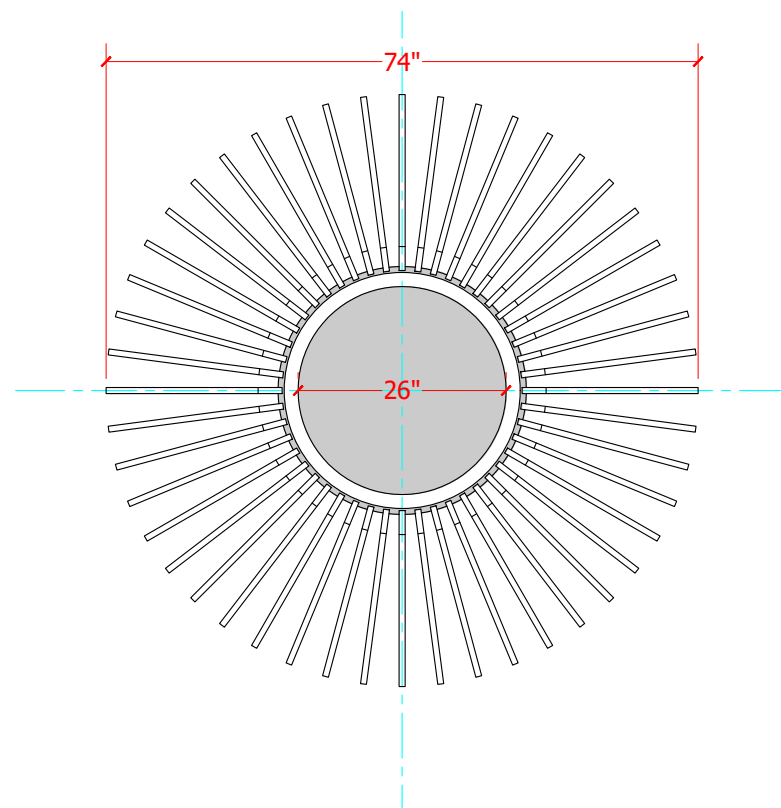

D1 COLUMN FEATURE (TOP)
Scale: 1/2"=1'-0"

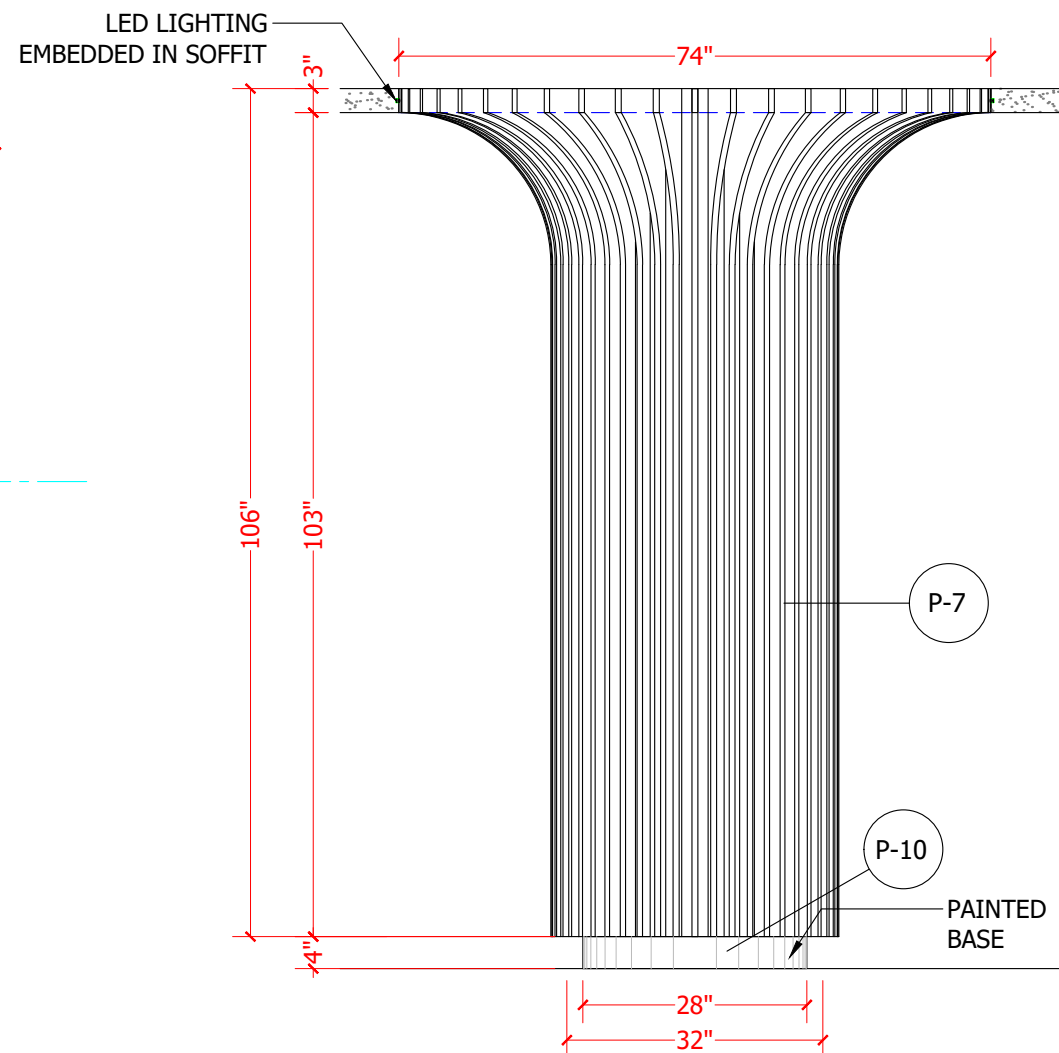

D2 COLUMN FEATURE (ELEV)
Scale: 1/2"=1'-0"

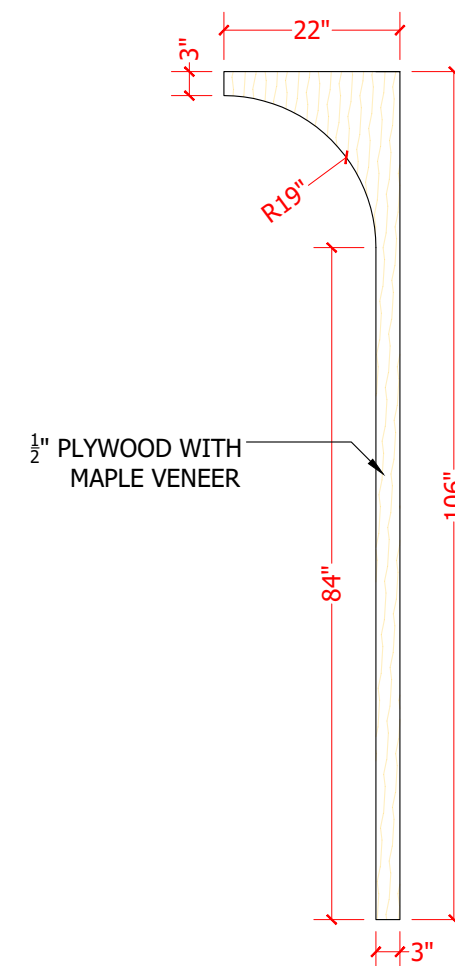

D3 COLUMN FEATURE (DETAIL)
Scale: 1/2"=1'-0"

CASEWORK FINISHES:
(P-7) OAK VENEER STAINED TO MATCH "BEIGEWOOD"
(P-10) SW 7020 BLACK FOX / FLAT



3CM (1 $\frac{1}{4}$ ") STONE COUNTER

Top View Dimensions:

- Overall Width: 32"
- Overall Depth: 34"
- Distance from front edge to first vertical divider: 29 $\frac{3}{4}$ "
- Distance from front edge to second vertical divider: 29 $\frac{1}{2}$ "
- Distance from front edge to back edge: 3"
- Distance from first vertical divider to second vertical divider: 19 $\frac{1}{2}$ "
- Distance from second vertical divider to back edge: 2"
- Distance from back edge to right side edge: 2"
- Distance from right side edge to corner: 4"
- Overall Depth (including counter): 34"

Side View Dimensions:

- Overall Height: 24"
- Counter Height: 10"
- Base Height: 14"

Other Features:

- Two drawers on the left side with handles.
- Two circular cutouts on the right side.
- Orange lines indicating a cut or break on the right side.

Technical drawing of a kitchen island with dimensions and labels:

- Labels:**
 - 3CM ($1\frac{1}{4}$ ") STONE COUNTER
 - 4"H X 21"D
- Dimensions (inches):**
 - Overall width: 23"
 - Overall depth: 42"
 - Top counter width: 12 $\frac{1}{2}$ "
 - Top counter depth: 5"
 - Top counter height: 3"
 - Main body width: 24"
 - Main body depth: 24"
 - Main body height: 10"
 - Bottom counter width: 19 $\frac{1}{2}$ "
 - Bottom counter depth: 4"
 - Bottom counter height: 4"
 - Left side height segments: 30", 25 $\frac{3}{4}$ ", 19 $\frac{1}{4}$ ", 6 $\frac{1}{8}$ ", 3"

S4 SECTION
Scale: 1"=1'-0"



30 1/2"

3CM (1 1/4") STONE COUNTER

24"

30 3/4"

36"

4"

19 1/2"

23"



CRAFTER OF FINE CABINETRY & MILLWORK

PROJECT CONTACT
NAME: DOUG SLOAN
PHONE: (941) 815-6235


PROJECT:
THE VISTAS AT GULF SHORE BLVD
4651 GULF SHORE BLVD.
NAPLES, FL 34103




CONTACT: GREG SHAVALIER

ORIGINAL DRAWING DATE	
7/10/26	
DRAWING REVISIONS	
1	
2	
3	
4	
5	
6	
7	


D-1

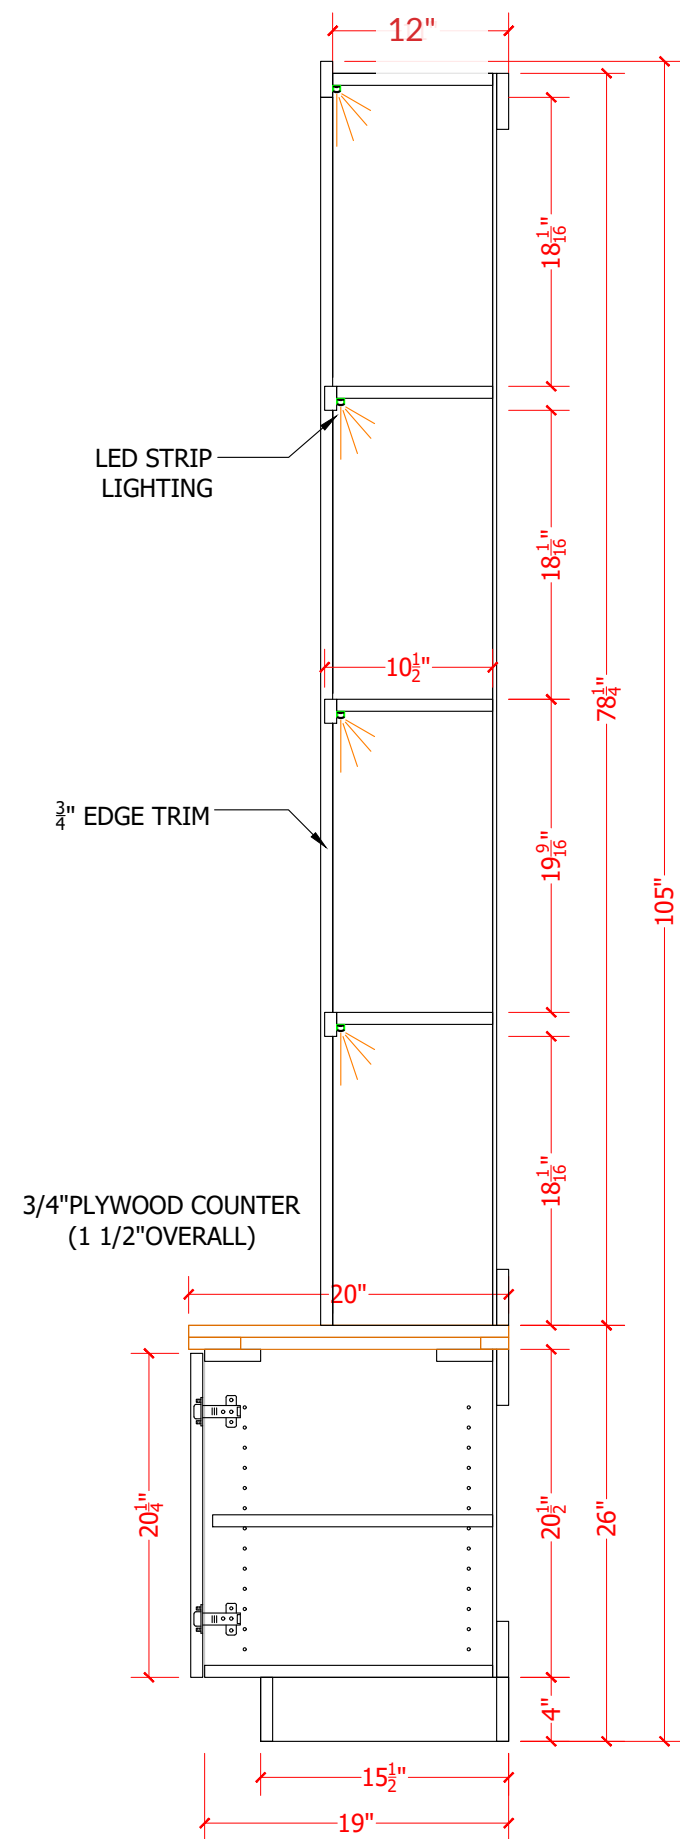

S7 SECTION
Scale: 1"=1'-0"

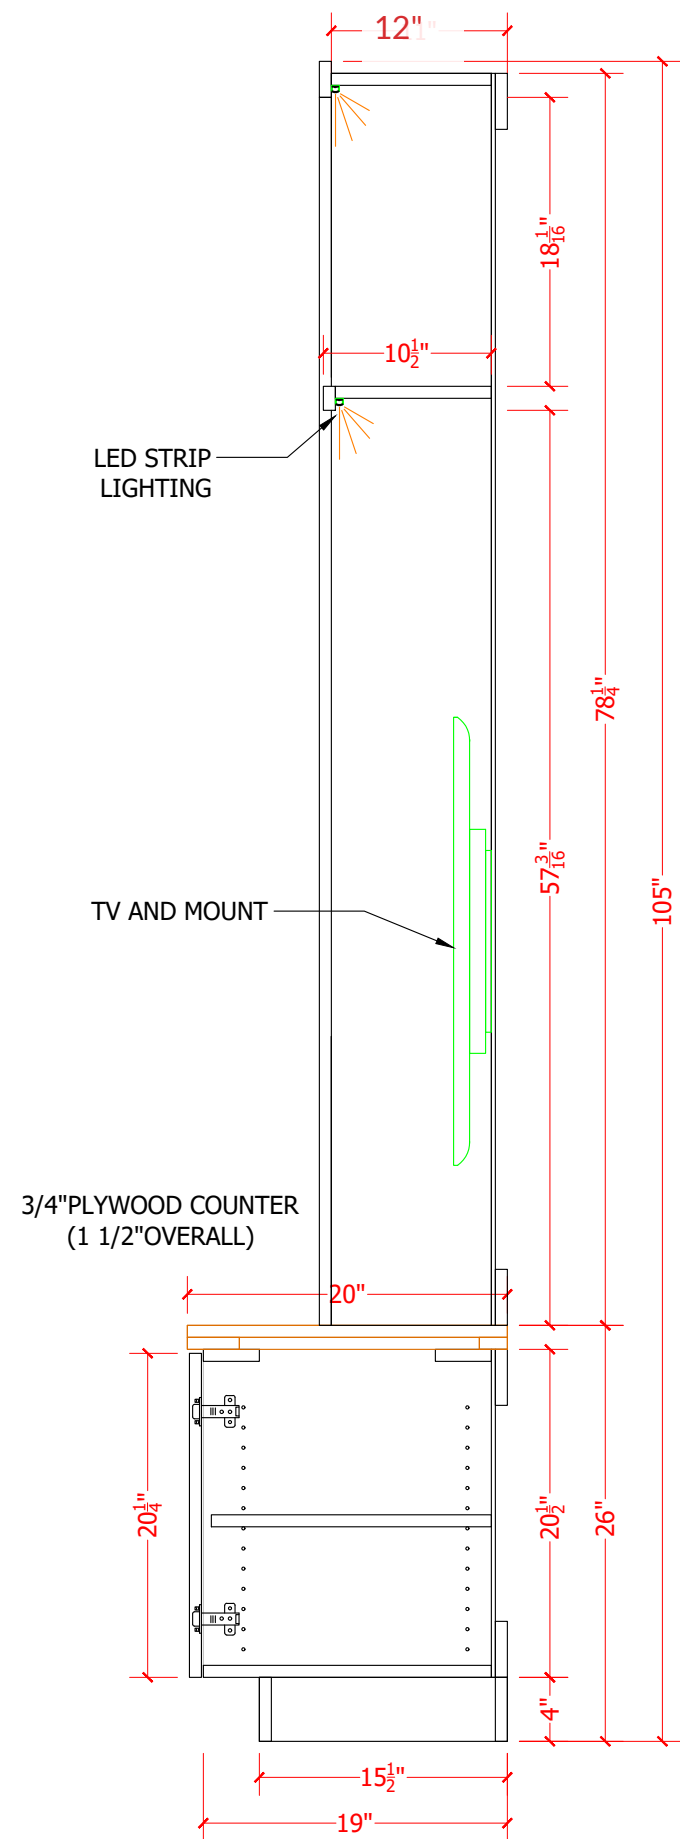

S8 SECTION
Scale: 1"=1'-0"

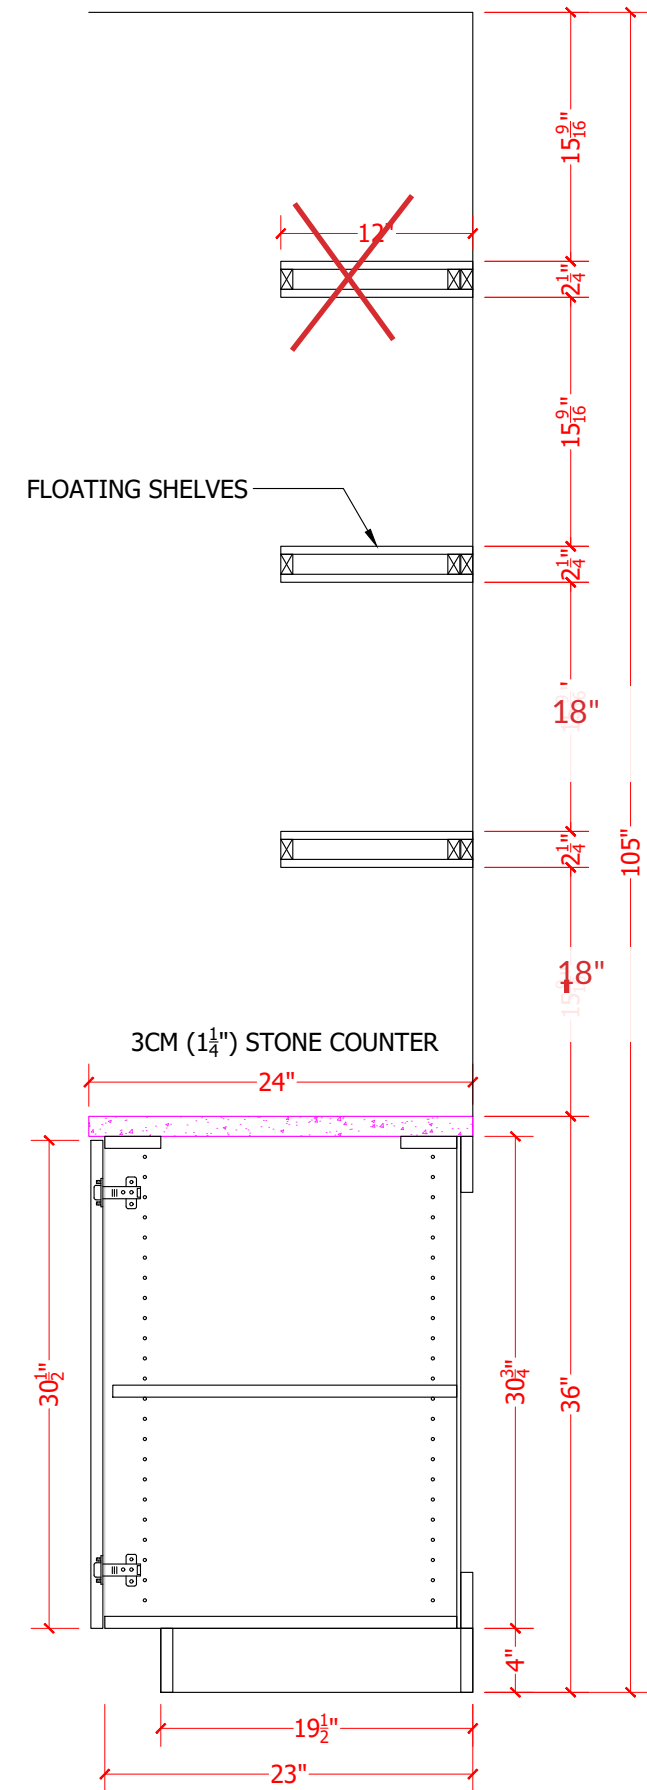

S9 SECTION
Scale: 1"=1'-0"

JOHN JEWELL
CRAFTER OF FINE CABINETS & MILLWORK

25550 TECHNOLOGY BLVD
PUNTA GORDA, FL 33950

PROJECT CONTACT
NAME: DOUG SLOAN
PHONE: (941) 815-6235


PROJECT:
THE VISTAS AT GULF SHORE BLVD
4651 GULF SHORE BLVD.
NAPLES, FL 34103

CLIENT:


BLUE HORIZON
CONSTRUCTION

CONTACT: GREG SHAVALIER


ORIGINAL DRAWING DATE	
7/10/26	
DRAWING REVISIONS	
△	
△	
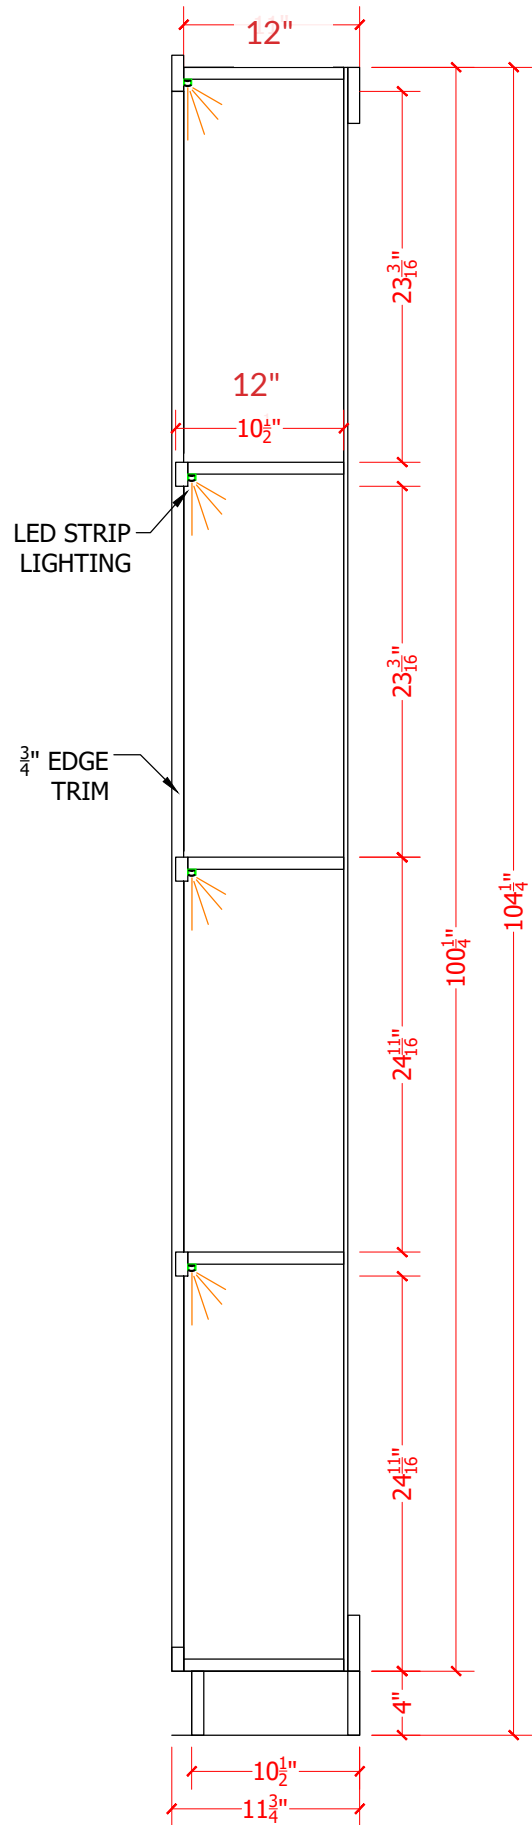

S10 SECTION
Scale: 1"=1'-0"

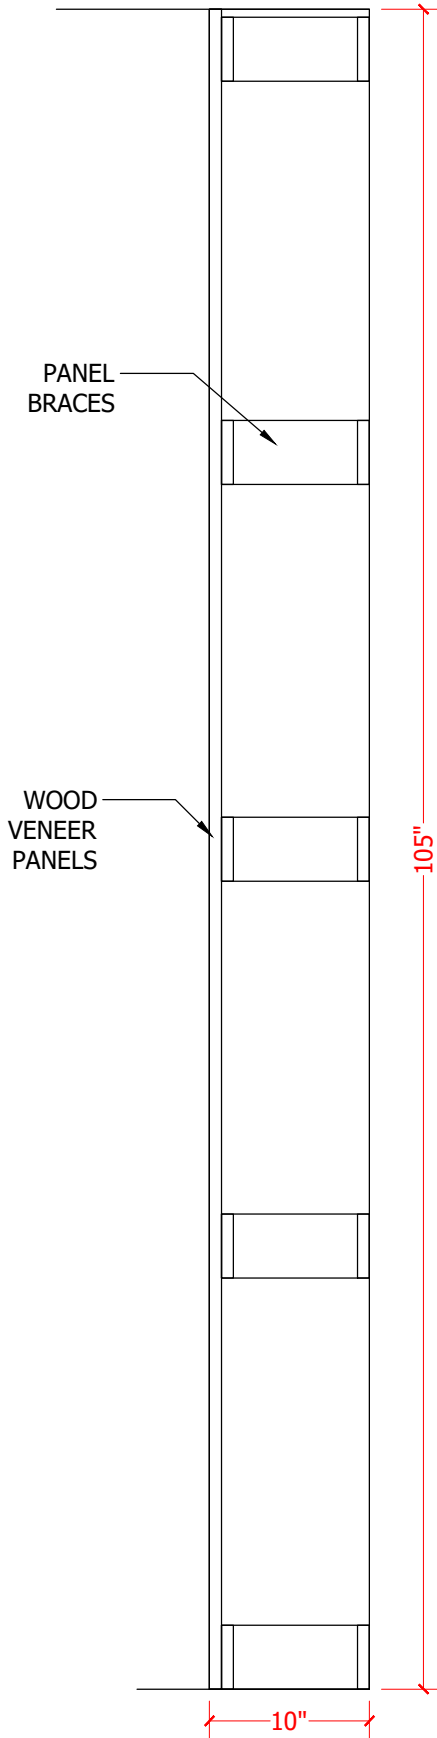

S11 SECTION
Scale: 1"=1'-0"

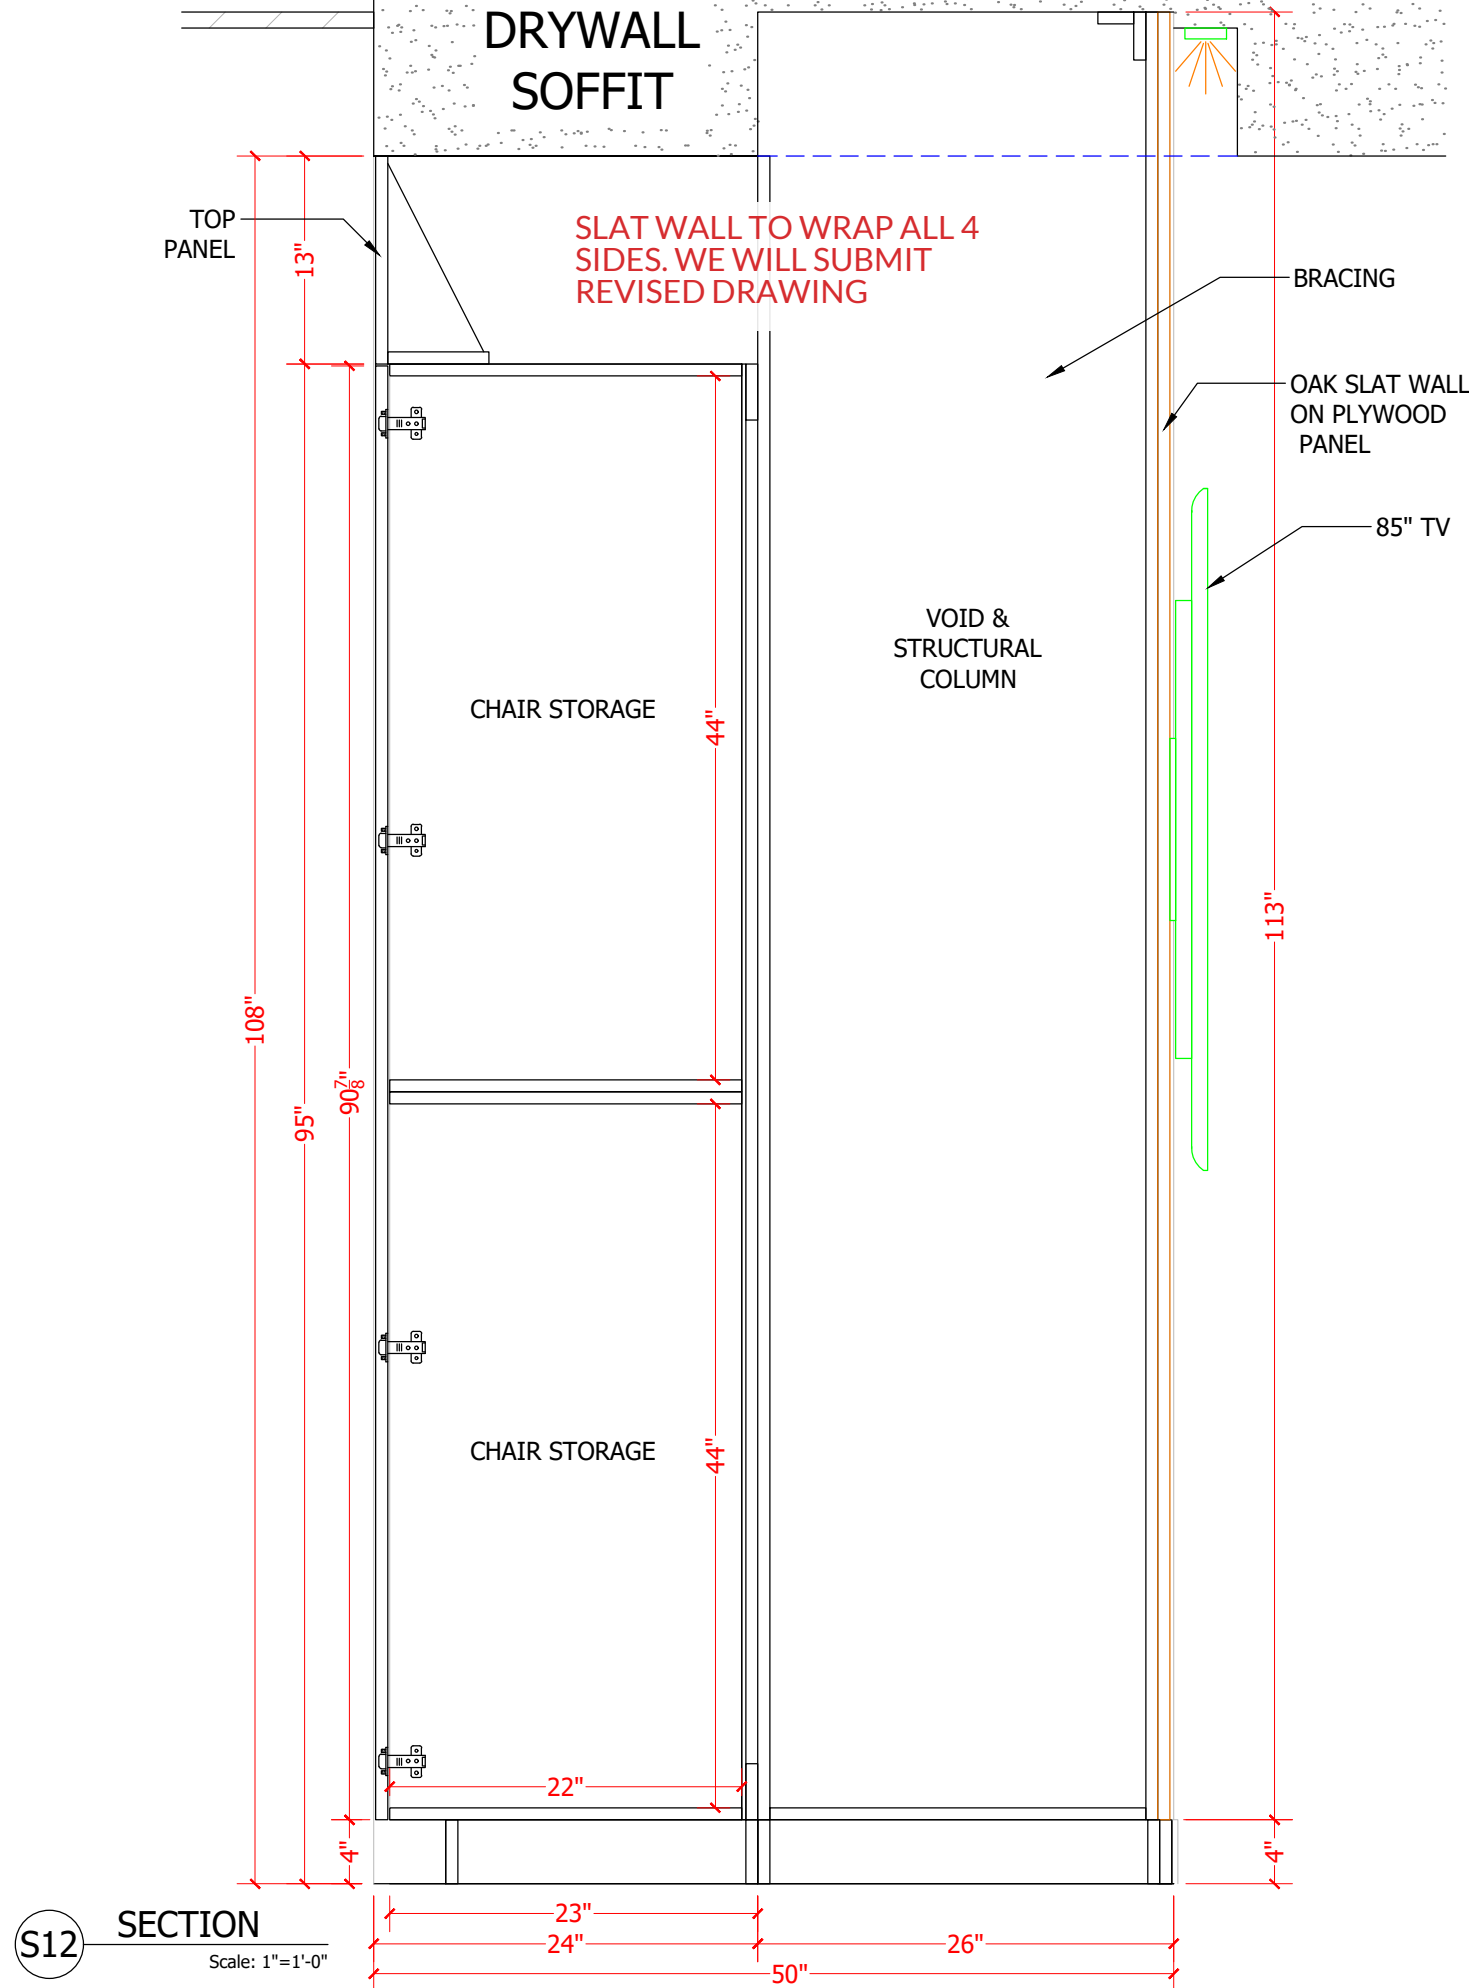

S12 SECTION
Scale: 1"=1'-0"

JOHN JEWELL
CRAFTER OF FINE CABINETS & MILLWORK

25550 TECHNOLOGY BLVD
PUNTA GORDA, FL 33950

PROJECT CONTACT
NAME: DOUG SLOAN
PHONE: (941) 815-6235

PROJECT:
THE VISTAS AT GULF SHORE BLVD
4651 GULF SHORE BLVD.
NAPLES, FL 34103


CLIENT:

BLUE HORIZON
CONSTRUCTION


CONTACT: GREG SHAVALIER

ORIGINAL DRAWING DATE	
7/10/26	
DRAWING REVISIONS	
△	
△	

D-3

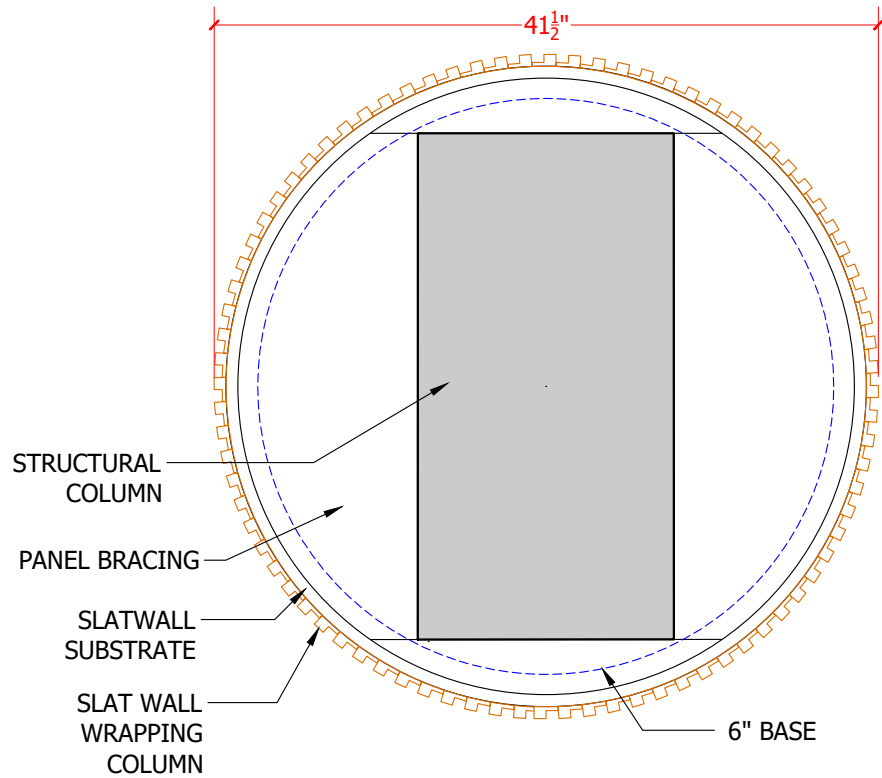


S13 SECTION
Scale: 1"=1'-0"

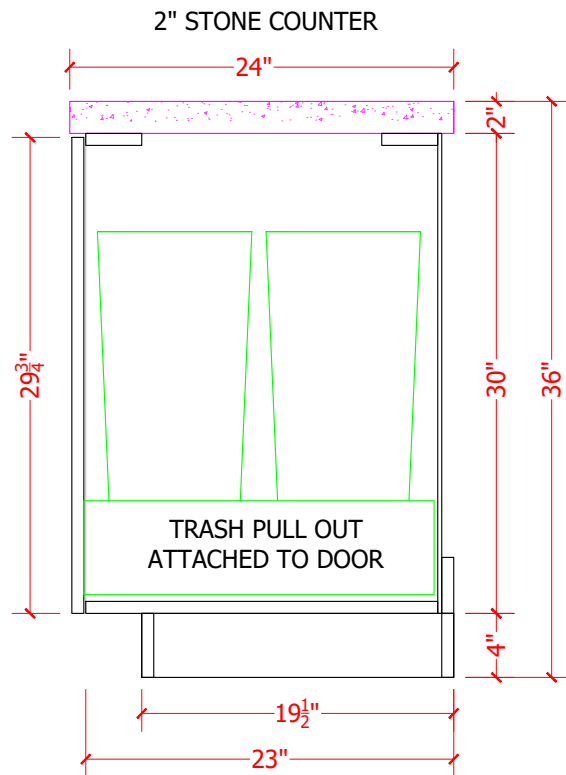

S15 SECTION
Scale: 1"=1'-0"

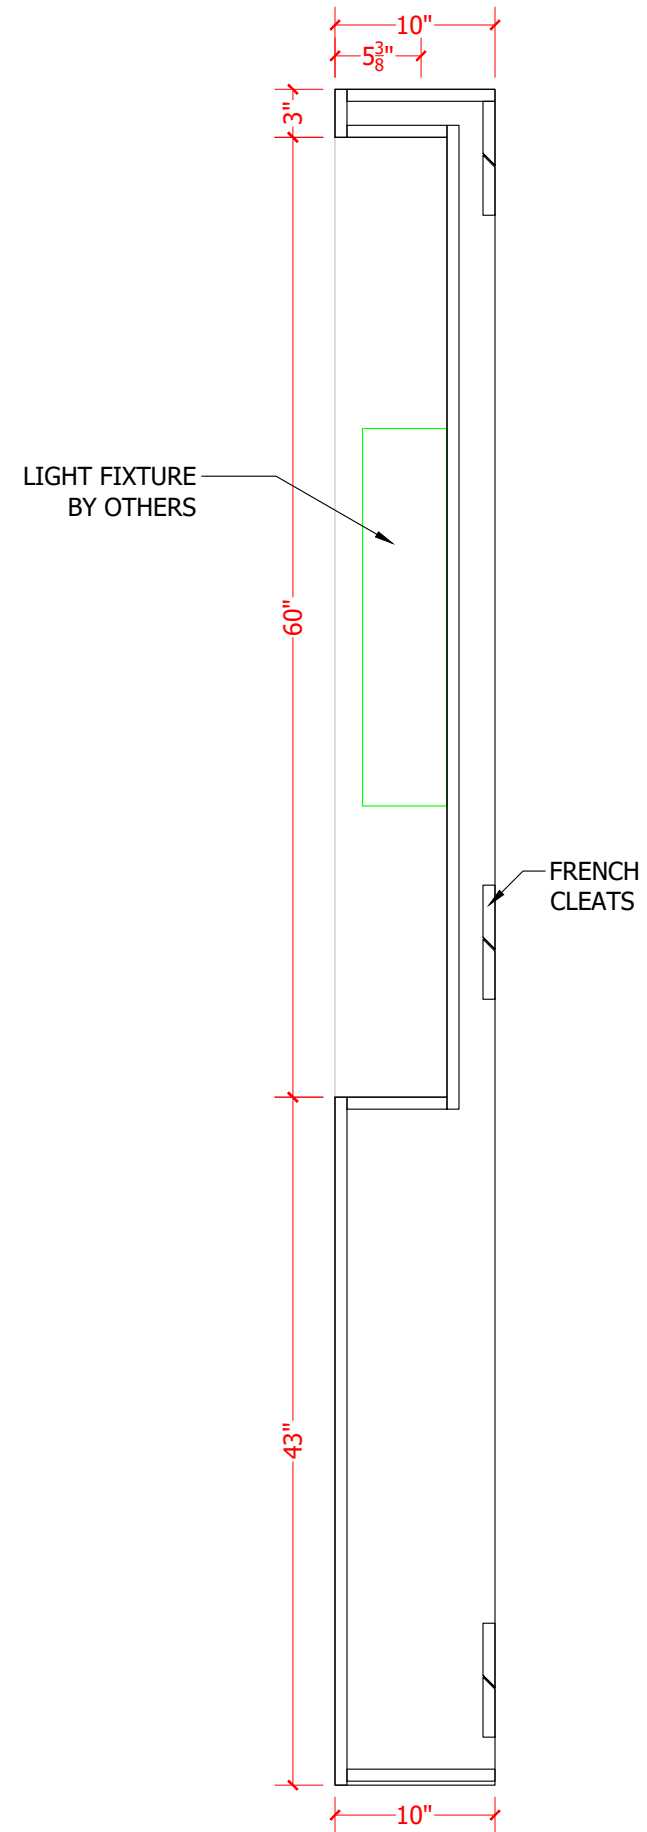

S16 SECTION
Scale: 1"=1'-0"

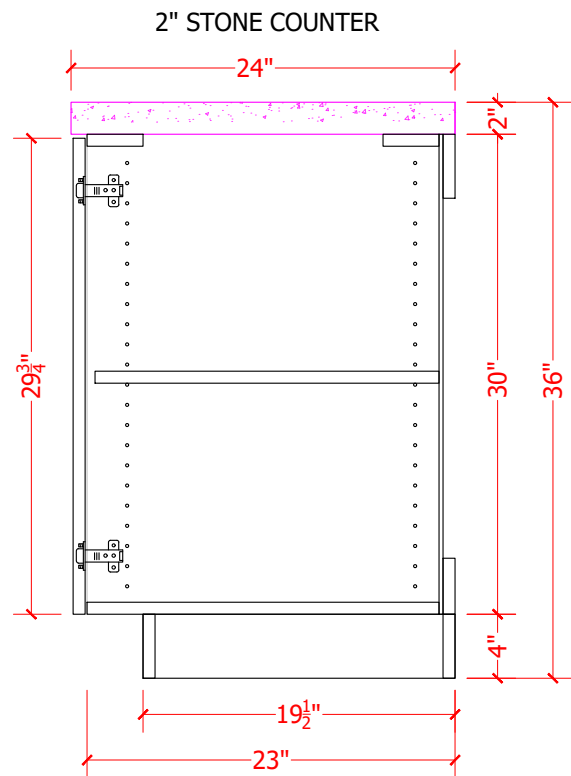

S14 SECTION
Scale: 1"=1'-0"



JOHN JEWELL

CRAFTER OF FINE CABINETRY & MILLWORK

25550 TECHNOLOGY BLVD
PUNTA GORDA, FL 33950

PROJECT CONTACT
NAME: DOUG SLOAN
PHONE: (941) 815-6235

PROJECT:
THE VISTAS AT GULF SHORE BLVD
4651 GULF SHORE BLVD.
NAPLES, FL 34103

CLIENT:



BLUE HORIZON
CONSTRUCTION

CONTACT: GREG SHAVALIER




ORIGINAL DRAWING DATE

7/10/26

DRAWING REVISIONS

△	
△	
D-4

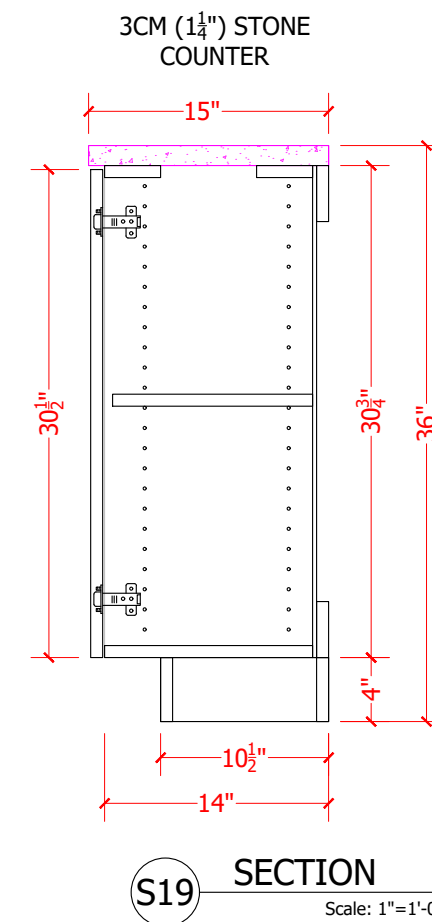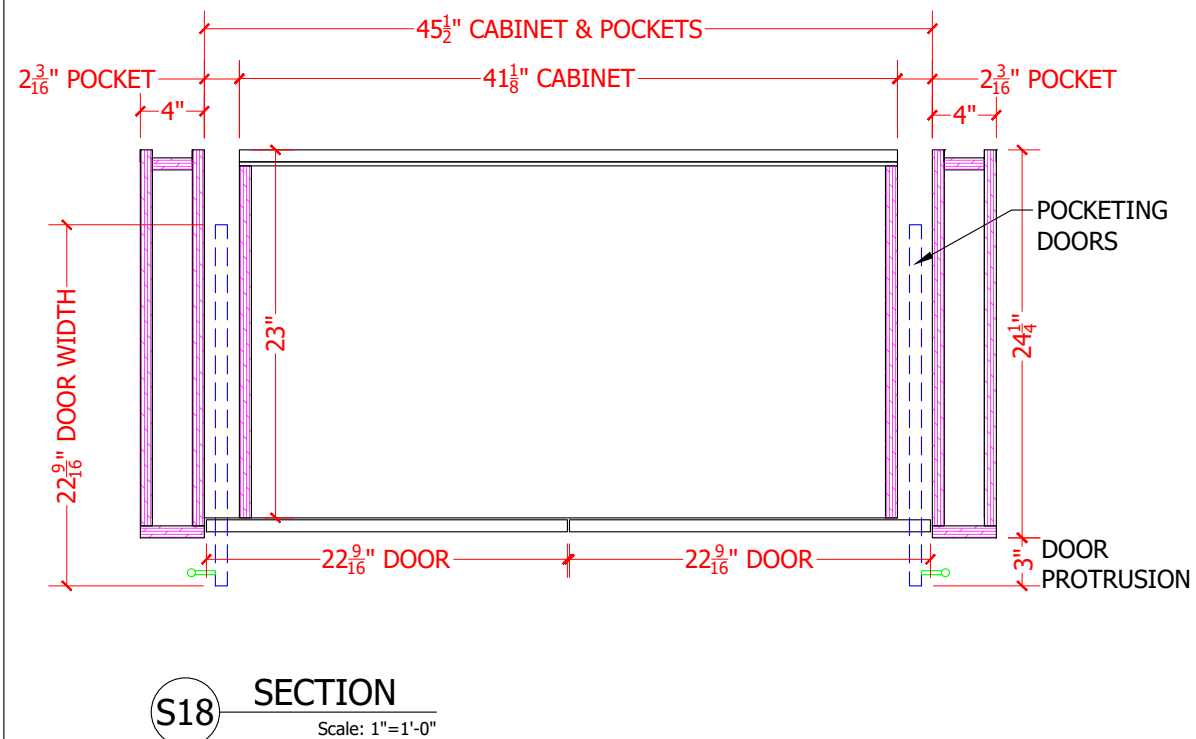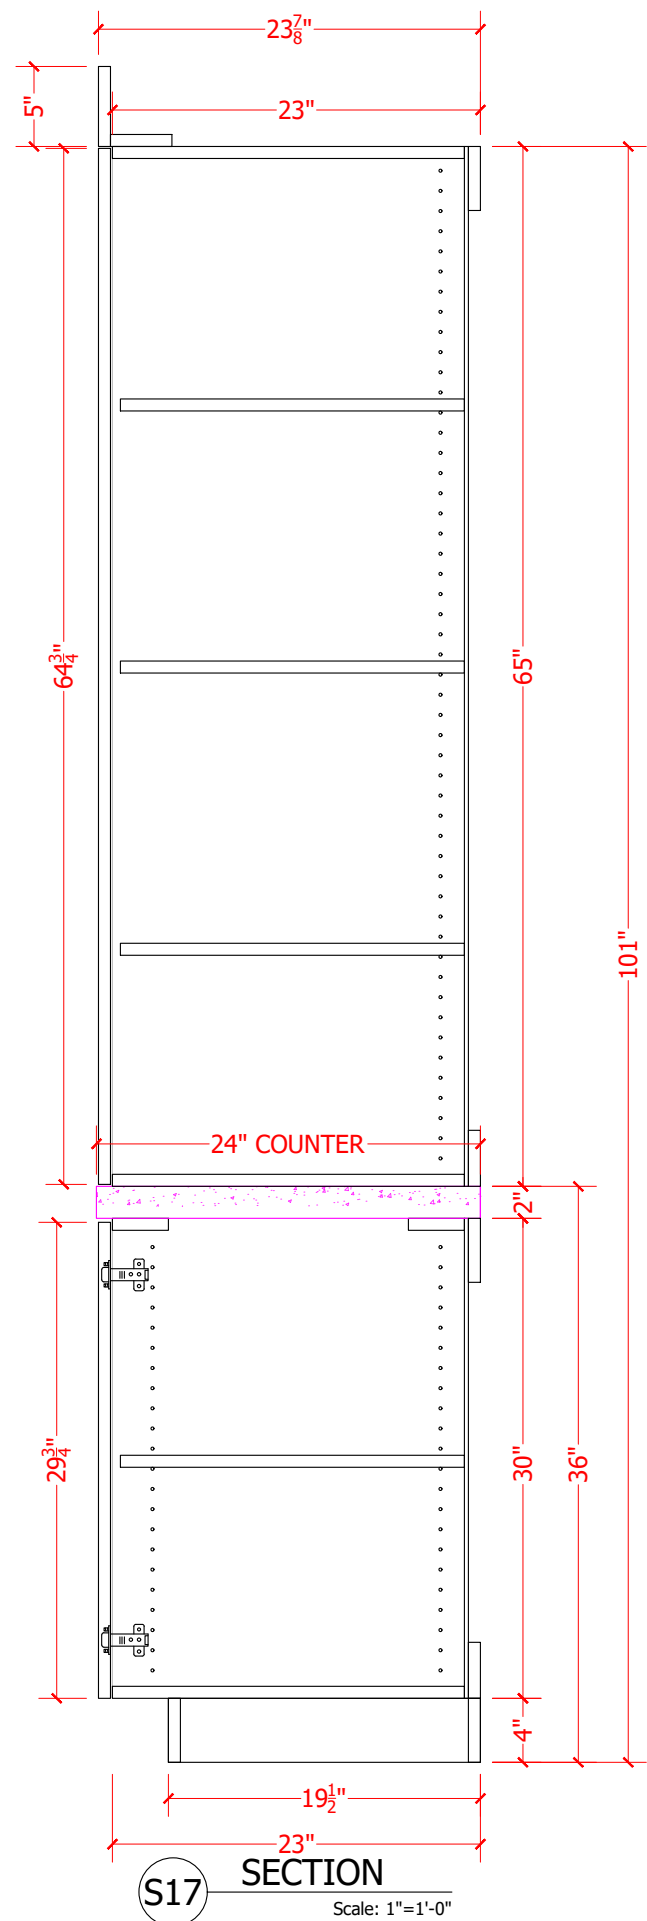

25550 TECHNOLOGY BLVD
PUNTA GORDA, FL 33950

PROJECT CONTACT
NAME: DOUG SLOAN
PHONE: (941) 815-6235

PROJECT:
THE VISTAS AT GULF SHORE BLVD
4651 GULF SHORE BLVD.
NAPLES, FL 34103

CLIENT:



CONTACT: GREG SHAVALIER

ORIGINAL DRAWING DATE	
7/10/26	
DRAWING REVISIONS	
1	
2	
3	
4	
5	
6	
7	

D-5

CLIP top BLUMOTION 110° hinges



- Features**
- BLUMOTION integrated into the hinge cup
 - New geometry for door thicknesses up to 26 (1")
 - New INSERTA design
 - Boring distance range 3 — 7 mm
 - Press-in hinges must be inserted with knock-in tool or universal insertion ram




Minimum reveal table					
3	0.5	1.0	1.8	2.7	4.3
4	0.5	1.0	1.7	2.5	3.8
5	0.5	0.9	1.7	2.4	3.4
6	0.5	0.9	1.6	2.3	3.2
7	0.5	0.9	1.6	2.2	3.0
B = boring dist.	16	19	22	24	26
T = door thickness					


Thickness greater than 26 trial app. recommended

Overlay

Frame

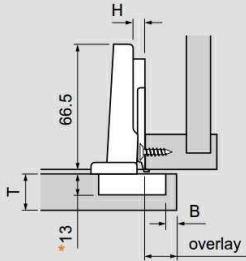


Panel

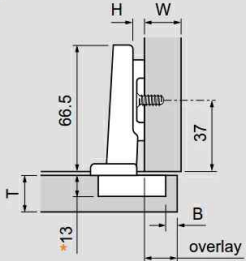


Partial/twin overlay

Frame

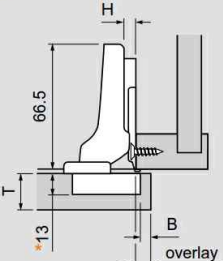


Panel

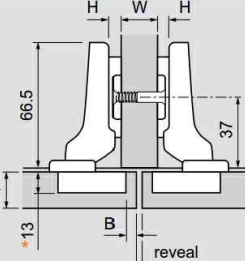


Inset

Frame

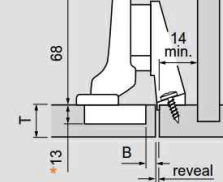

NOTE: For this application use a half-ported hinge and mounting plate 175H5030.21

Panel

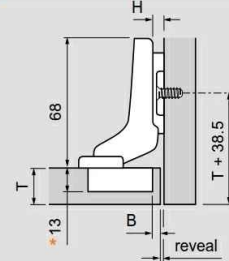

* All 35 mm and 8 mm holes must be a minimum of 13 mm deep

H	Overlay						P	S
0	14	15	16	17	18	12	21.5	
3	11	12	13	14	15	15	24.5	
4.5	9.5	10.5	11.5	12.5	13.5	16.5	26	
6	8	9	10	11	12	18	27.5	
9	5	6	7	8	9	21	30.5	
	3	4	5	6	7	Fixed dist.	X = 11	
B = boring distance								

NOTE: 4.5 plate is only for use in frame cabinets, 9 plate is only for panel cabinets

Straight-arm	Self close
Screw-on	71B3550
Press-in	71B3580
EXPANDO	71B358E
INSERTA	71B3590

H	Overlay						P	S
0	4.5	5.5	6.5	7.5	8.5	21.5	31	
	3	4	5	6	7	Fixed dist.	X = 1.5	
B = boring distance								

H	Reveal						W	P	S
0	7	5	3	1	—	16			
	10	8	6	4	2	19	21.5	31	
	13	11	9	7	5	22			
	3	4	5	6	7				
B = boring distance									

Half-ported (9.5 mm)	Self close
Screw-on	71B3650
Press-in	71B3680
INSERTA	71B3690

Abbreviations					
H	=	Plate height			
P	=	Door protrusion			
S	=	Side arm protrusion			
W	=	Side panel width			
X	=	Fixed distance			

Full-ported (18 mm)	Self close
Screw-on	71B3750
Press-in	71B3780
INSERTA	71B3790

* All 35 mm and 8 mm holes must be a minimum of 13 mm deep

Subject to technical modifications without notice. © 2010 LIT.HNG4101.08.10



TANDEM plus BLUMOTION 563H

Application




New features

- Four-dimensional adjustment
- Elongated holes for depth adjustment
- Bottom mount holes on 15", 18" and 21"
- 100 lb static load capacity

Description

- Full extension concealed drawer runners
- Face frame or panel cabinets
- BLUMOTION soft closing
- TANDEM smooth running action
- Available in 9" to 21" lengths
- 13 (1/2") to 16 (5/8") drawer thickness
- Made in the USA

Basic components

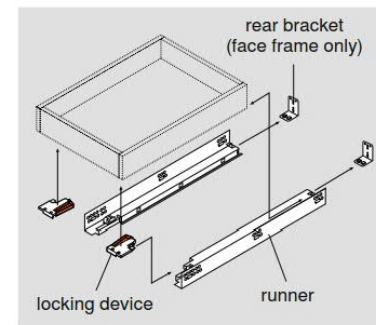

Other applications



pg 22



pg 24



pg 28




pg 29

Components

Runner set

One set required per drawer

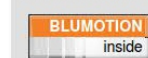

for overall cabinet depth	drawer length	TANDEM plus BLUMOTION
610 (24")	533 (21")	563H5330B
533 (21")	457 (18")	563H4570B
457 (18")	381 (15")	563H3810B
381 (15")	305 (12")	563H3050B
305 (12")	229 (9")	563H2290B10
Wood screw for installation		606N or 606P
System screw for installation		662.1150.HG

Side adjustable locking device



- One right and one left required per drawer
- With side-to-side adjustment
- Captive right and self-aligning left device
- Self-adjusting drawer length tolerance
- Steel base with synthetic, spring-loaded release levers
- Minimum inside drawer width 170 (6-11/16")
- Height adjustment +3 (1/8")
- Side adjustment ±1.5 (1/16")
- For use with 563/569 series runners only
- For other options see page 32

Part no.

Right locking device	T51.1901 R
Left locking device	T51.1901 L
Installation screw	606N or 606P

Using TANDEM page 10

Drawer preparation page 11

Rear mounting bracket for frame cabinets



For use when installing TANDEM runners in face frame cabinets. Not necessary for panel cabinet installation.

- Two required per drawer
- Depth and lateral self-alignment
- Zinc-coated steel
- For 9" TANDEM rear attachment options see page 35

Part no.

Non-handed bracket	295.3750.01
Installation screw	606N or 606P

Accessories page 42

Assembly aids page 44



25550 TECHNOLOGY BLVD
PUNTA GORDA, FL 33950

PROJECT CONTACT
NAME: DOUG SLOAN
PHONE: (941) 815-6235

PROJECT:
THE VISTAS AT GULF SHORE BLVD
4651 GULF SHORE BLVD.
NAPLES, FL 34103

CLIENT:



CONTACT: GREG SHAVALIER

ORIGINAL DRAWING DATE	
7/10/26	
DRAWING REVISIONS	
△	
△	
CS-1

Dovetail Drawer Boxes

Available in: •Brown Soft Maple •Walnut •Sap Cherry •
Sap Red Oak •Soft Maple •Baltic Birch Plywood •Poplar
(Other species available on request.)



Assembled or unassembled

- 5/8" ASPEN SIDES WITH DOVETAIL JOINERY
- 30 SHEEN CATALYZED CLEAR COAT FINISH
- 1/4" THICK BOTTOMS (1/2" ON DRAWERS OVER 36" WIDE)
- 1/8" TOP ROUND OVER EDGES
- 4" WIDE X 2"HIGH SCOOP AVAILABLE FOR ROLLOUT DRAWERS
- AVAILABLE IN ANY HEIGHT, WIDTH, AND DEPTH COMBINATION
- CUSTOM MADE IN THE U.S.A.



4WCSC SERIES

SOFT-CLOSE WASTE CONTAINERS

Looking to conceal garbage without compromising design? Rev-A-Shelf's 4WCSC Series with Blum soft-close is your solution. Each waste container kit includes an elegant dovetail maple drawer box along with your choice of a single or double garbage bin configuration. To accommodate your disposal needs, the durable polymer bins are available in 35 Qt. and 50 Qt. quantities. No matter the size and configuration you choose, rest assured that your product will remain stable and glide smoothly on Blum's TANDEM heavy duty full-extension concealed runners. We've also included our patented door mount brackets, which allow up to five inches of flexibility for trouble-free installation on any door style.



FRAMELESS NOTE:

Frameless minimum openings are the same as face frame. While the slides (the widest point) will fit tightly within the cabinet, the drawer box is slightly smaller to ensure flawless action.

LIDS AVAILABLE*
for 35 & 50 qt. Containers
See Page 32



4WCSC-1835DMND-2

PRODUCT #s	DESCRIPTION	PRODUCT DIMENSIONS	MIN. OPENING	FINISH	SET PER CARTON	WEIGHT PER CARTON
Wood Soft-Close Waste Containers						
4WCSC-1535DM-1	Single 35 Qt. Kit w/ Soft-Close	12" (305 mm)W x 21 3/4" (553 mm)D x 19 1/2" (496 mm)H	12"W	Silver/Wood	1	23.5 lbs.
4WCSC-1550DM-1	Single 50 Qt. Kit w/ Soft-Close	12" (305 mm)W x 21 3/4" (553 mm)D x 23 3/8" (594 mm)H	12"W	Silver/Wood	1	24 lbs.
4WCSC-1835DM-2	Double 35 Qt. Kit w/ Soft-Close	15" (381 mm)W x 21 3/4" (553 mm)D x 20 3/8" (518 mm)H	15"W	Silver/Wood	1	28 lbs.
4WCSC-2150DM-2	Double 50 Qt. Kit w/ Soft-Close	18" (458 mm)W x 21 3/4" (553 mm)D x 24 1/4" (616 mm)H	18"W	Silver/Wood	1	33 lbs.
4WCSC-1835DMND-2	Double 35 Qt. Kit w/ Soft-Close for Inset	15" (381 mm)W x 22 1/2" (572 mm)D x 20 3/8" (518 mm)H	15 1/4"	Silver/Wood	1	28 lbs.

*IMPORTANT NOTE: Lids can only be used on the front bin on these units!

www.rev-a-shelf.com

REV-A-SHELF®

45



JOHN JEWELL

CRAFTER OF FINE CABINETRY & MILLWORK

25550 TECHNOLOGY BLVD
PUNTA GORDA, FL 33950

PROJECT CONTACT
NAME: DOUG SLOAN
PHONE: (941) 815-6235

PROJECT:
THE VISTAS AT GULF SHORE BLVD
4651 GULF SHORE BLVD.
NAPLES, FL 34103

CLIENT:



CONTACT: GREG SHAVALIER

ORIGINAL DRAWING DATE

7/10/26

DRAWING REVISIONS

△	
△	
CS-2

PRODUCT DATA SHEET

DCN SERIES

N Series: 3/4" Barrel Diameter
Grade 1 Cam Lock

ANSI/BHMA Grade 1
E07261 | E07271

Woodwork Institute (WI)
acknowledged product

SPECIFICATIONS

Keying: Can be keyed together with other N Series locks

Cylinder length: Four sizes available (see table with dimensions on page 2)

Rekeyable: Easily rekeyable via cylinder retainer clip
ANSI/BHMA: Passed ANSI/BHMA A156.11 Grade 1 performance requirements. Equivalent to E07261 / E07271.

US Patent Nos: 5,038,589; 5,737,950

Body: Zinc die cast

Cylinder: Zinc die cast, pin tumbler

Standard function: Key removable in locked or unlocked position.

Key retaining function: Alternate key-retaining shifters are available separately for key removable in locked position only.

Cams: 2 reversible cams work in all positions

Face: 1" face covers splintering, no additional trim ring required

Finish: 26D, US3, 10B or US19

Packaged: Packed 10 per box

KEYING INFORMATION

Keyway: N Series (equivalent to National D4291 4-pin or D4292 5-pin system)

Keys: Includes 2 keys per lock

Stock keying: KD/KA - 4 pin standard

Stock KA#: 101, 103, 107, 915, 51001, 51002, 51003, 51004

Masterkeyed: 5 pin standard

Grand masterkeyed: Available

Keyblank 4-pin: KBN-4-NP

(equivalent to NA14, 1069L)

Keyblank 5-pin: KBN-5-NP

(equivalent to NA12, 1069LA)

INCLUDED ACCESSORIES

Straight cam #DCNP-100-SC

Offset cam #DCNP-100-BC

Anti-rotation plate #DCNP-500-ARP

OPTIONAL ACCESSORIES

See page 2.

DCN

Keyway: N Series, National Keyway

Handing: Includes 2 cams that work in all handings (door or drawer)

DCN SERIES FEATURES

- Non-handed—Field reversible locking positions: right-hand, left-hand, vertical and inverted
- Only 2 cams required—Ships with reversible straight and offset cams that meet requirements of all locking positions
- Easy rekeyability—Allows for a quick installation and increased productivity




- Anti-rotation plate—Eliminates lock rotation, prevents loosening of fixing nut, and provides additional security in particleboard applications

AVAILABLE FINISHES



INCLUDED CAMS

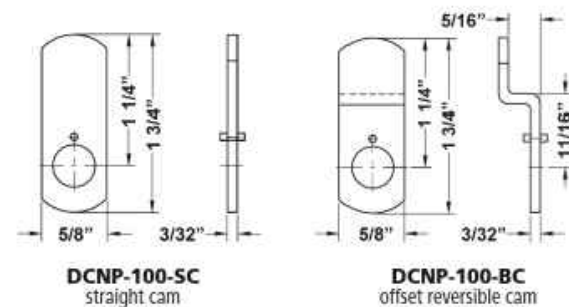

WARNING: This product can expose you to chemicals including chromium, which is known to the State of California to cause cancer and birth defects or other reproductive harm. For more information go to www.P65Warnings.ca.gov.



SALICE

JETPRESS

Exedra

Pocket door system with cam-assisted door extraction and cushioned door insertion.

Doors characteristics

Max. weight for each door : 30 kg (distributed evenly).

Thickness from 18 mm to 30 mm.

Width from 400 mm to 900 mm.

Height from 1333 mm to 1575 mm (consult our technical support department for the verification).





Height from 1576 mm to 2530 mm.

Door adjustment:

- vertical adjustment $\pm 4/-1$ mm;
- horizontal adjustment ± 2 mm;
- front adjustment ± 4 mm.



Mechanism movement as the door leaves the recess.

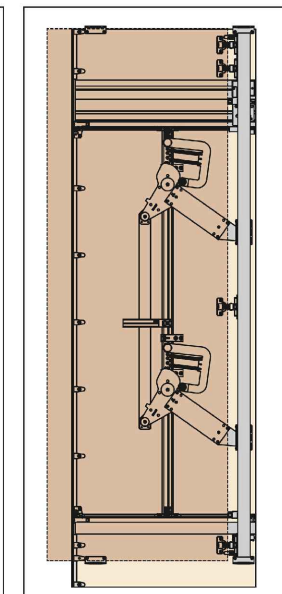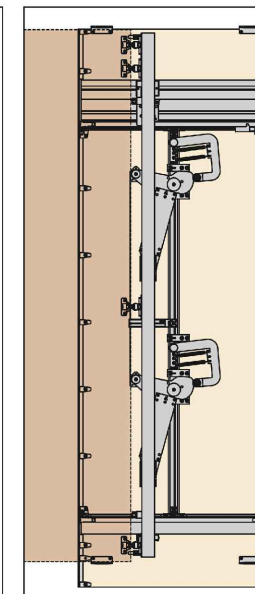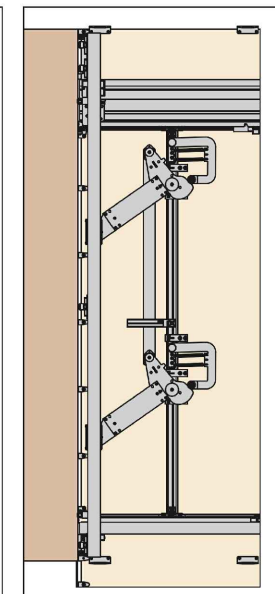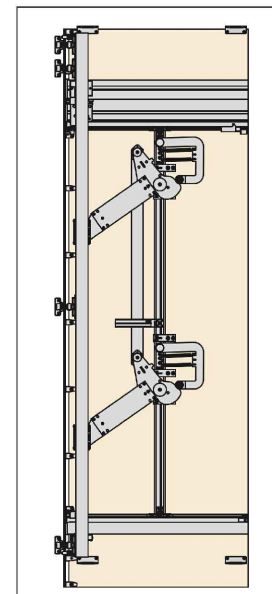

JOHN JEWELL

CRAFTER OF FINE CABINETS & MILLWORK

25550 TECHNOLOGY BLVD
PUNTA GORDA, FL 33950

PROJECT CONTACT
NAME: DOUG SLOAN
PHONE: (941) 815-6235

PROJECT:
THE VISTAS AT GULF SHORE BLVD
4651 GULF SHORE BLVD.
NAPLES, FL 34103

CLIENT:



CONTACT: GREG SHAVALIER

ORIGINAL DRAWING DATE

7/10/26

DRAWING REVISIONS


△	
△	
CS-3



4 1/2" Full Mortise Adjustable Square Spring Hinge Brush Nickel Finish


HAFELE

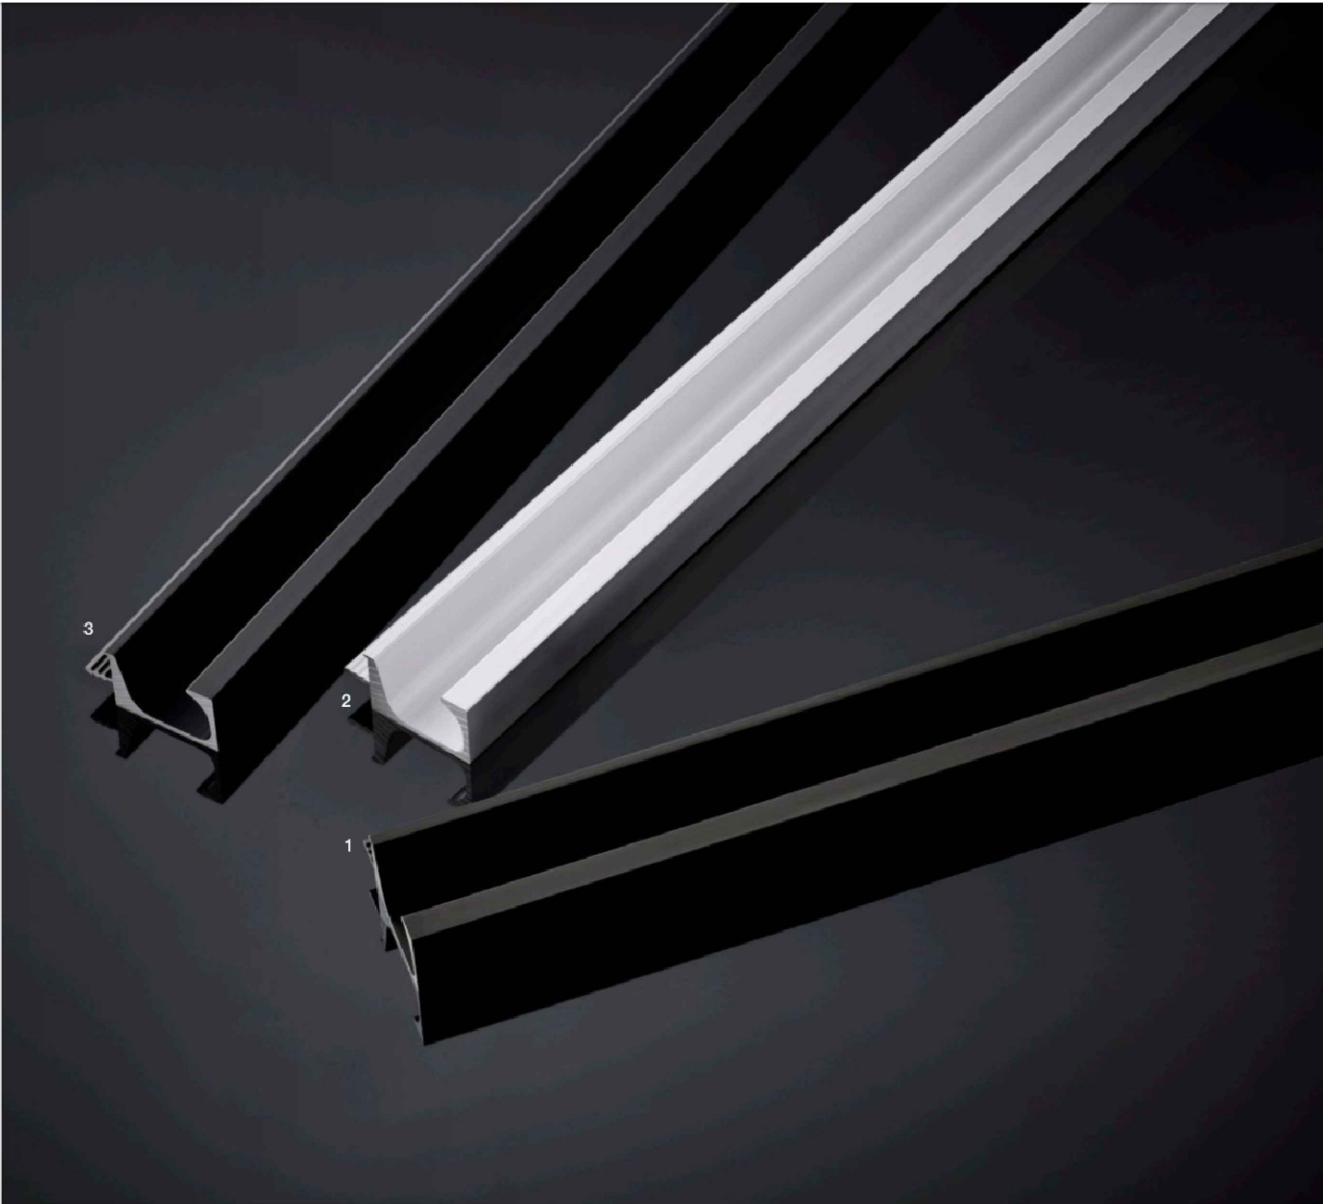

Minimalist

	Finish	Material	Length	Item No.
1	matte black	Aluminum	2500 (98 7/16")	126.27.310
2	satin aluminum	Aluminum	2500 (98 7/16")	126.27.036
3	black	Aluminum	2500 (98 7/16")	126.27.306

SATIN ALUMINUM

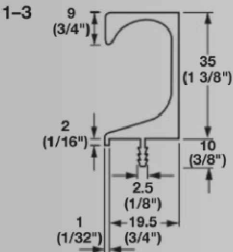



JOHN JEWELL
CRAFTER OF FINE CABINETS & MILLWORK

25550 TECHNOLOGY BLVD
PUNTA GORDA, FL 33950

PROJECT CONTACT
NAME: DOUG SLOAN
PHONE: (941) 815-6235

PROJECT:
THE VISTAS AT GULF SHORE BLVD
4651 GULF SHORE BLVD.
NAPLES, FL 34103

CLIENT:



BLUE HORIZON
CONSTRUCTION

CONTACT: GREG SHAVALIER

ORIGINAL DRAWING DATE	
7/10/26	
DRAWING REVISIONS	
△	
△	
CS-4